

**COUNTY OF SAN MATEO  
PLANNING AND BUILDING DEPARTMENT**

**DATE:** October 6, 2022

**TO:** Zoning Hearing Officer

**FROM:** Planning Staff

**SUBJECT:** Consideration of a Use Permit Renewal, pursuant to Section 6512.6 of the Zoning Regulation, to allow the continued operation of an existing wireless telecommunications facility operated by AT&T Mobility. The project site is located on the roof of a commercial building located at 333 O'Neill Avenue in the unincorporated Harbor Industrial area of San Mateo County.

County File Number: PLN 2011-00077 (AT&T)

**PROPOSAL**

The project applicant, Kathryn Leal of Epic Wireless, proposes on behalf of AT&T to renew an existing Use Permit (PLN 2011-0007) to allow the continued operation of a wireless telecommunication facility located on the roof of the Public Storage building located at 333 O'Neill Avenue. The existing facility consists of a commercial storage building with telecommunication facilities.

**RECOMMENDATION**

1. That the Zoning Hearing Officer approve the Use Permit Renewal, County File No. PLN 2011-00077 by making the required findings and adopting the conditions of approval listed in Attachment A.

**BACKGROUND**

Report Prepared By: Tiare Peña, Project Planner; [Tpena@smcgov.org](mailto:Tpena@smcgov.org)

Applicant: Kathryn Leal of Epic Wireless for AT&T Mobility

Owner: PSA Institutional Partners, LP

Public Notification: Ten (10) day advanced notification for the hearing was mailed to property owners within 300 feet of the project parcel and a notice for the hearing posted in a newspaper San Mateo Times.

Location: 333 O'Neill Avenue, Harbor Industrial District

APN(s): 046-010-100

Size: 1.02 acres

Existing Zoning: M-1 (Light Industrial District)

General Plan Designation: General Industrial

Sphere-of-Influence: City of Belmont

Existing Land Use: Commercial storage building with telecommunication facilities.

Water Supply: Mid-Peninsula Water District

Sewage Disposal: Harbor Industrial Sewer Maintenance District

Flood Zone: FEMA Flood Insurance Rate Map designation indicates parcel as Zone X, Community Panel No. 06081C0169F, dated July 16, 2015.

Environmental Evaluation: The project is categorically exempt pursuant to Section 15301, Class 1, of the California Environmental Quality Act (CEQA) Guidelines for the continued operation of existing public or private facilities involving no physical changes or expansion of use.

Setting: The subject parcel is located at the northern edge of the unincorporated Harbor Industrial District and is surrounded by a wide variety of industrial land uses. The City of Belmont borders O'Neill Avenue to the north and the Belmont Trailer Park is located 170 feet east of the property.

Chronology:

<u>Date</u>	<u>Action</u>
September 1, 2011	- Use Permit approved for rooftop telecommunications facility.
February 2, 2016	- Minor modification to replace three antennas and install other associated equipment within the equipment shelter.
March 27, 2019	- Major amendment submitted for the installation of the diesel generator.
June 6, 2019	- Major amendment approved at Zoning Hearing Officer public hearing.
November 1, 2021	- Application received for use permit renewal for planning application number PLN 2011-00077 (AT&T)

December 1, 2021 - Application deemed complete

October 6, 2022 - Zoning Hearing Officer public hearing

## **DISCUSSION**

### **A. KEY ISSUES**

#### **1. Conformance with the San Mateo County General Plan**

The proposal has been reviewed against and found to be consistent with all applicable General Plan (GP) Policies. The applicable GP policies are listed and discussed below.

- a. Visual Quality Policies. The project is consistent with GP Policies 4.14. (*Appearance of Development*), 4.20 (*Utility Structures*), and 4.35 (*Urban Area Design Concept*) because it minimized the visual impact of the antenna facilities by installing them on an existing building (rather than constructing a new free-standing tower structure) and utilizing FRP screens that are painted to match the building to which they are affixed. The maximum height of the FRP screens is 58 feet above grade, which is below the 75-foot maximum stipulated by the M-1 Zoning District.
- b. Urban Land Use Policies. The proposed project complies with GP Policies 8.15 and 8.23 (*Land Use Compatibility*) because the antenna facility does not generate any significant visual, noise, light, or odor impacts to the surrounding neighborhood. The project continues to comply with GP Policies 8.34 (*Zoning Regulations*), 8.35 (*Uses*), and 8.38 (*Height, Bulk, and Setbacks*) and is consistent with the industrial and commercial land uses allowed by the M-1 District, and the project meets all M-1 District development standards (as discussed in greater detail below in Section 2 of this report).

#### **2. Conformance with Zoning Regulations**

The subject Public Storage building was constructed in 1999, and the building permit (BLD 97-1681) received final approval in October 1999. The use of the building as a commercial storage facility is consistent with uses permitted in the M-1 (Light Industrial) Zoning District. Specifically, the use is consistent with those permitted by Zoning Regulations §6271.149, which allows storage warehouses in the M-1 District. The rooftop telecommunications facility may be permitted in the M-1 District subject to the issuance of a Use Permit, which is discussed in detail below in Section 3 of this report.

The existing storage building is consistent with the development standards stipulated in Zoning Regulations §6273 (*Minimum Building Site*), §6274

(*Yards Required*), and §6275 (*Signage*). The telecommunications facility, and the FRP structures that screen said facilities, will reach a maximum height of 58 feet above grade, which is below the 75-foot maximum stipulated by Zoning Regulations §6272 (*Building Height Limit*). No additional physical changes are proposed.

3. Wireless Telecommunications Facilities Regulations

Effective January 9, 2009, the San Mateo County Board of Supervisors adopted a Wireless Telecommunication Facilities (WTF) Ordinance. Renewals of use permits approved after the effective date of the WTF Ordinance shall only be approved if all conditions of the original use permit have been satisfied and will continue to be met. Continued compliance with applicable standards is discussed below:

- a. Development and Design Standards. The subject building is a commercial storage building located within the Harbor Industrial District, which supports a wide variety of industrial land uses. The existing AT&T facility at this location is consistent with §6512.2A and §6512.2B because the area does not contain any sensitive habitat and is not within a residentially zoned neighborhood. The applicant demonstrated, through the use of existing and proposed coverage maps, that there is a significant coverage gap in the unincorporated Harbor Industrial area and adjacent sections of the cities of San Carlos and Belmont. This facility greatly improves the coverage issues displayed in the coverage maps.

The antenna facilities on the roof of the Public Storage building are screened within a series of FRP structures that are painted to match the existing building. The maximum height of the facility is 58 feet above grade, which is well below the 75-foot maximum allowed by the M-1 Zoning District.

- b. Performance Standards. Based on the RF emissions analysis submitted with the renewal application and included as Attachment H of this report, composite exposure levels will be a maximum of 6.57% of the FCC's public exposure limit for a person at ground level. This estimate of RF emissions includes worst-case assumptions (all antennas operating at full power at the same time for all carriers) and actual exposure levels are often well below these maximum values. Based on the findings illustrated in this report, the facility generates exposure levels that are in compliance with the FCC's standards and do not pose any significant health risks.

The facility is required to receive and maintain all necessary licenses and registrations from the Federal Communications Commission (FCC),

California Public Utilities Commission (CPUC), and any other applicable regulatory bodies. AT&T is also required to supply the Planning and Building Department with evidence of these licenses and registrations. If any license is ever revoked, AT&T is obligated to inform the Planning and Building Department of the revocation within 10 days of receiving such notice.

4. Use Permit Findings

In order to approve the use permit renewal to allow the continued operation of this facility, the Zoning Hearing Officer must make the following findings:

- a. *That the establishment, maintenance and/or conducting of the proposed use will not, under the circumstances of this particular case, be detrimental to the public welfare or injurious to property or improvements in said neighborhood.*

The Radio Frequency Analysis (Attachment D) for this project indicates that the facility, coupled with the existing ambient conditions, will generate exposure levels that are 6.57% of the FCC's public exposure limit for a person at ground level. The antennas facilities are screened within FRP enclosures that are painted to match the existing building. The maximum height of the antennas and the FRP enclosures are 58 feet above grade, which is well below the 75-foot maximum stipulated by the M-1 Zoning District. The facility does not produce any significant noise, odor, or light impacts and, as such, is not detrimental to the public welfare or injurious to property or improvements in the neighborhood.

- b. *That the use permit renewal I for this cellular telecommunication facility is necessary for the public health, safety, convenience or welfare of the community.*

The use is for personal telecommunication services. The FCC has established the desirability and need for mobile and wireless telephone service to facilitate communication between mobile units and the existing wire-dependent telephone system. The wireless network supported by this antenna facility provides greater mobility and accessibility than the landline networks can offer. The system is considered necessary for public health, safety, convenience and welfare.

5. Conformance with Conditions of last Permit Approval

Staff has reviewed the previous Use Permit conditions of approval for AT&T (PLN 2011-000770 last approved on September 1, 2011, and has determined that AT&T mobility is in compliance with all previous conditions, See attachment I. No additional physical changes are

proposed as part of the renewal. Previous conditions that remain relevant are included in Attachment A of this staff report.

**B. ENVIRONMENTAL REVIEW**

The proposed telecommunications facility is categorically exempt from the California Environmental Quality Act (CEQA) under provisions of §15301, Class 1 of the California Environmental Quality Act for the continued operation of existing public or private facilities involving no physical changes or expansion in use.

**C. REVIEWING AGENCIES**

1. Building Inspection Section
2. Department of Public Works

**ATTACHMENTS**

- A. Recommend Findings and Conditions of Approval
- B. Location Map
- C. Site Plan/Antenna/Equipment Plan/Exterior Elevations/Equipment Details
- D. Radio Frequency Analysis
- E. PLN 2011-00077 Conditions from the 2011 Use Permit Approval

TGP:mda – TGP GG0312\_WM.U.DOCX

County of San Mateo  
Planning and Building Department

**RECOMMENDED FINDINGS AND CONDITIONS OF APPROVAL**

Permit or Project File Number: PLN 2011-00077      Hearing Date: October 6, 2022

Prepared By: Tiare Peña, Project Planner      For Adoption By: Zoning Hearing Officer

**RECOMMENDED FINDINGS**

For the Environmental Review, Find:

1. That the project is categorically exempt from the California Environmental Quality Act (CEQA) under provisions of §15301, Class 1, for the continued operation of existing public or private facilities involving no additional physical changes and no expansion of use.

For the Use Permit, Find:

2. That the establishment, maintenance and/or conducting of the use will not, under the circumstances of this particular case, be detrimental to the public welfare or injurious to property or improvements in said neighborhood because the facility will not introduce any significant visual, noise, odor, or light impacts to the surrounding neighborhood.
3. That the approval of this use permit renewal for an existing cellular telecommunication facility is necessary for the public health, safety, convenience or welfare of the community as the site provides telecommunications coverage to the surrounding community, which serves as a benefit to both private and public users.

**CONDITIONS OF APPROVAL**

1. This approval applies only to the proposal, documents, and plans described in this report and submitted to and approved by the Zoning Hearing Officer on October 6, 2022. Modifications beyond that which was approved by the Zoning Hearing Officer will be subject to review and approval by the Community Development Director and may require review at a public hearing. Minor modifications that are largely consistent with this approval may be approved at the discretion of the Community Development Director.

2. This permit shall be valid for ten (10) years from the date of this approval and shall expire on October 6, 2032. If continuation of this use is desired, the applicant shall file a use permit renewal application with the Planning and Building Department six (6) months prior to its expiration and pay the fees applicable at that time.
3. This use permit renewal shall be for the continued operation of the existing telecommunication facility only. Any substantial change or change in intensity of use shall require an amendment to the use permit, which requires an application for amendment, payment of applicable fees, and consideration at a public hearing.
4. The applicant shall continue to maintain all rooftop facilities a light brown/beige color to match that of the existing building.
5. The applicant shall continue to maintain the color of all existing facilities in a manner that is consistent with the color samples on file. Over time paint colors fade and, as result, facilities may become more visually prominent than initially proposed. The applicant shall continue to take all necessary measures to ensure that the site remains consistent with all approved colors. This includes all screen walls and rooftop facilities approved by this permit.
6. This installation shall be removed in its entirety at that time when this technology becomes obsolete, when the facility is no longer needed to achieve coverage objectives, or if the facility remains inactive for six consecutive months. If any of these circumstances occur, the entire facility, including all antennas and associated equipment, cables, power supplies, etc., shall be removed and the site shall be returned to its pre-construction state to the extent practicable.
7. The applicant shall keep their FCC license active and in good standing throughout this permit's 10-year term. The applicant shall immediately notify the Planning and Building Department if any changes to their license occur.



TGP:mda – TGPGG0312\_WMU.DOCX





**COUNTY OF SAN MATEO - PLANNING AND BUILDING DEPARTMENT**

# **ATTACHMENT B**

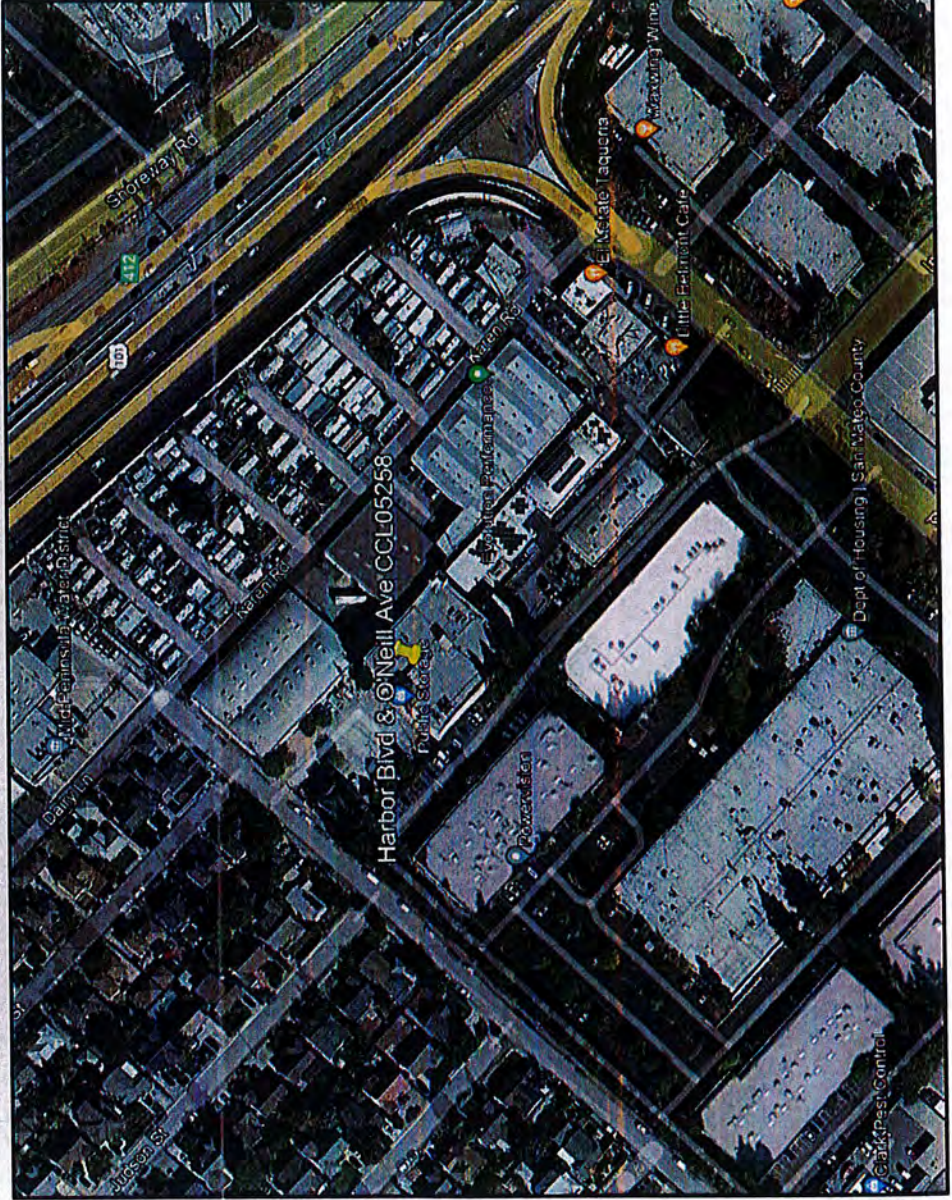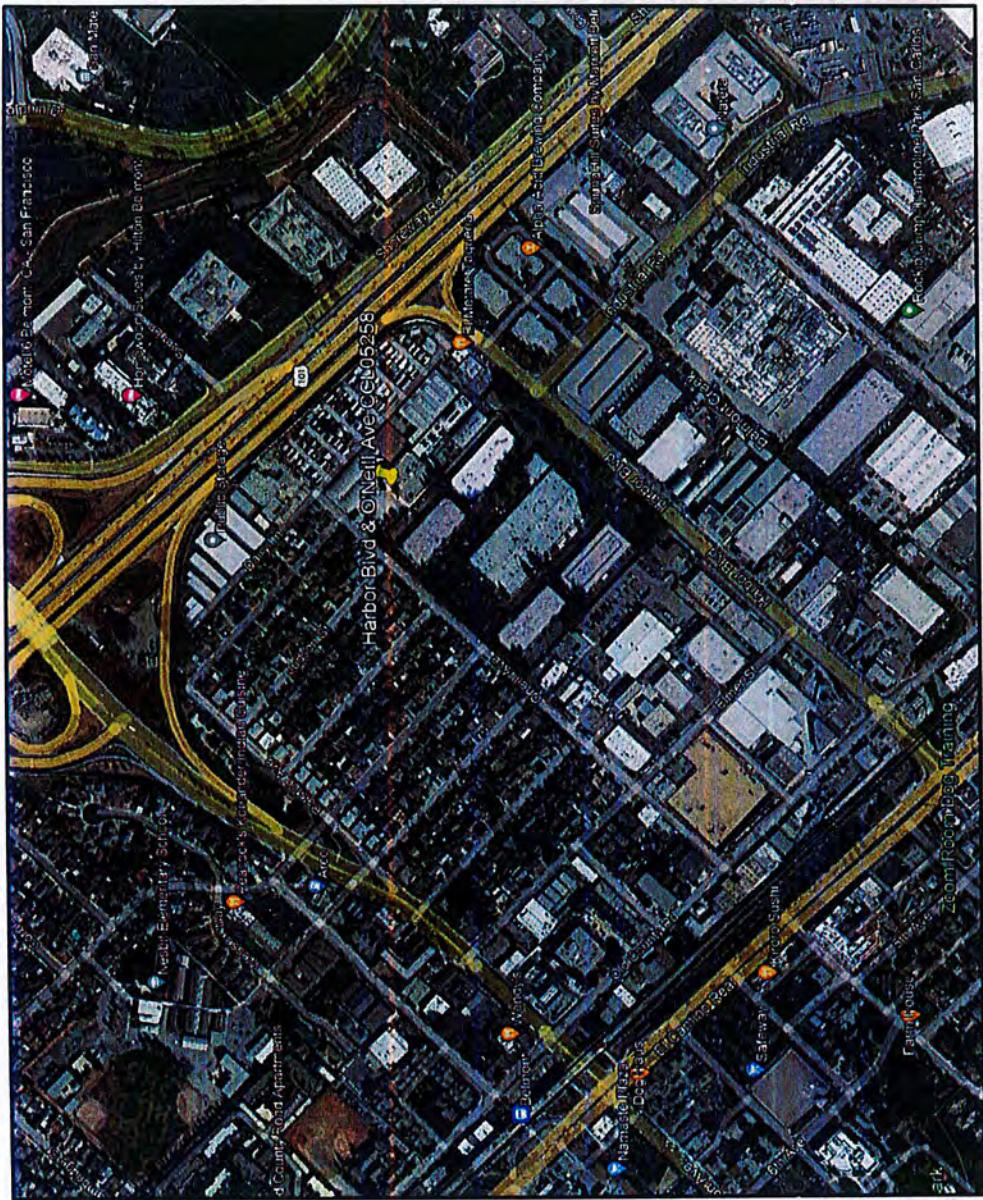



**COUNTY OF SAN MATEO - PLANNING AND BUILDING DEPARTMENT**

# **ATTACHMENT C**

**CODE COMPLIANCE**

ALL WORK AND MATERIALS SHALL BE PERFORMED AND INSTALLED IN ACCORDANCE WITH THE CURRENT EDITIONS OF THE FOLLOWING CODES AS ADOPTED BY THE LOCAL GOVERNING AUTHORITIES. NOTHING IN THESE PLANS IS TO BE CONSIDERED TO PERMIT WORK NOT CONFORMING TO THESE CODES.

- 2016 CALIFORNIA ADMINISTRATIVE CODE, CHAPTER 10, PART 1, TITLE 24 CODE OF REGULATIONS
- 2016 CALIFORNIA BUILDING CODE (CBC)
- 2016 CALIFORNIA RESIDENTIAL CODE (CRC) WITH APPENDIX H, PATIO COVERS, BASED ON THE 2015 IRC (PART 2.3)
- 2016 CALIFORNIA GREEN BUILDINGS STANDARDS CODE (CALGREEN) (PART 11) (AFFECTED ENERGY PROVISIONS ONLY)
- 2016 CALIFORNIA FIRE CODE (CFC), BASED ON THE 2015 IFC, WITH CALIFORNIA AMENDMENTS (PART 9)
- 2016 CALIFORNIA MECHANICAL CODE (CMC), BASED ON THE 2015 UMC (PART 4)
- 2016 CALIFORNIA PLUMBING CODE (CPC), BASED ON THE 2015 UPC (PART 5)
- 2016 CALIFORNIA ELECTRICAL CODE (CEC) WITH CALIFORNIA AMENDMENTS, BASED ON THE 2014 NEC (PART 3)
- 2016 CALIFORNIA ENERGY CODE (CEC)-PART 6
- ANSI / BIA-1A-222-G
- 2016 NFPA 101, LIFE SAFETY CODE
- 2016 NFPA 72, NATIONAL FIRE ALARM CODE
- 2016 NFPA 13, FIRE SPRINKLER CODE

USID: 118858  
 FA #: 10150734  
 LTE 7C  
 PTN#: 3701A0E93A  
 PACE#: MRSFR045494  
 LTE 6C  
 PTN#: 3701A0AHPR  
 PACE#: MRSFR037285  
 LTE 5C  
 PTN#: 3701A0AHRM  
 PACE#: MRSFR037532  
 LTE 4C  
 PTN#: 3701A0AJ65  
 PACE#: MRSFR037362  
 ANTENNA MODIFICATIONS  
 PTN#: 3701A0BBM3  
 PACE#: MRSFR038382



**SITE NUMBER:** CCL05258  
**SITE NAME:** HARBOR BLVD & O'NEILL AVE  
**SITE TYPE:** ROOFTOP/INDOOR EQUIPMENT  
**ADDRESS:** 333 O'NEILL AVENUE  
 BELMONT, CA 94002

**APPROVALS**

THE FOLLOWING PARTIES HEREBY APPROVE AND ACCEPT THESE DOCUMENTS & AUTHORIZE THE SUBCONTRACTOR TO PROCEED WITH CONSTRUCTION DESCRIBED HEREIN. ALL DOCUMENTS ARE SUBJECT TO REVIEW BY LOCAL BUILDING DEPARTMENT & MAY IMPOSE CHANGES AND MODIFICATIONS.

DISCIPLINE:	SIGNATURE	DATE
RF ENGINEER:		
AT&T PM:		
CIVIL:		
A&E:		
SAQ PM:		
PROPERTY OWNER:		

Plan set to serve as the as-built drawings for the renewal of the land use permit previously approved under PLN2011-00077

No proposed changes to the existing facility

PREPARED FOR

5001 EXECUTIVE PKWY,  
SAN RAMON CA 94583

Vendor:

**IS INFRASTRUCTURE**  
AZ - CA - CO - FL - GA - HI - IL - IN - MD - MI - NY - TX - UT

2030 MAIN STREET, SUITE 200  
IRVINE, CALIFORNIA 92614

AT&T Site ID:

**CCL05258**

**PROJECT TEAM**

**APPLICANT / LESSEE:**  
 AT&T MOBILITY  
 5001 EXECUTIVE PKWY,  
 SAN RAMON, CA 94583  
 CONTACT: ROZ DUNICAN  
 EMAIL: rd459@att.com  
 PHONE: (925) 518-9917

**CONSTRUCTION MANAGER:**  
 AT&T MOBILITY  
 CONTACT: PHUNG NGUYEN  
 EMAIL: phung.nguyen@att.com  
 PH: (925) 277-6490

**RF ENGINEER:**  
 AT&T MOBILITY  
 CONTACT: PREEINDER SINGH  
 EMAIL: ps7945@att.com  
 PH: (925) 277-6104

**PROJECT MANAGER, LEASING & ZONING:**  
 JS INFRASTRUCTURE PARTNERS  
 1150 BALLENA BLVD, SUITE 259  
 ALAMEDA, CA 94501  
 CONTACT: CHASE OHS  
 EMAIL: colohs@isp.com  
 PH: (805) 680-5453

**ENGINEER:**  
 JS INFRASTRUCTURE PARTNERS  
 2030 MAIN STREET, SUITE 200  
 IRVINE, CA 92614  
 CONTACT: FRANCIS Q. DONG  
 EMAIL: fdong@isp.com  
 PH: (949) 247-7767x112

**A&E MANAGER:**  
 JS INFRASTRUCTURE PARTNERS  
 2030 MAIN STREET, SUITE 200  
 IRVINE, CA 92614  
 CONTACT: JASON OFFICER  
 EMAIL: jofficer@isp.com  
 PH: (619) 370-4859



**MODIFICATION TO AN UNMANNED TELECOMMUNICATIONS FACILITY, CONSISTING OF THE FOLLOWING:**

- SWAP (3) EXISTING ANTENNAS IN POS 2.3.4 WITH (3) NEW 8-PORT ANTENNAS (TYPICAL EACH SECTOR, TOTAL OF 9)
- SWAP (1) RRUS-12 WITH (1) NEW RRUS 4415 B25 (TYPICAL EACH SECTOR, TOTAL OF 3)
- INSTALL (1) NEW RRU 4478 B14 NEAR ANTENNA (TYPICAL EACH SECTOR, TOTAL OF 3)
- INSTALL (1) NEW RRU 4478 B5 NEAR ANTENNA (TYPICAL EACH SECTOR, TOTAL OF 3)
- INSTALL (1) NEW RRU 4426 B66 NEAR ANTENNA (TYPICAL EACH SECTOR, TOTAL OF 3)
- INSTALL (1) NEW RRUS-E2 829 NEAR ANTENNA (TYPICAL EACH SECTOR, TOTAL OF 3)
- INSTALL (1) NEW DC-12 IN EQUIPMENT AREA ON EXISTING RACK
- INSTALL (1) NEW DC-6 SURGE ARRESTOR NEAR ANTENNAS (TYPICAL EACH SECTOR, TOTAL OF 3)
- INSTALL (4) PROPOSED POWER TRUNKS AND (3) PROPOSED FIBER TRUNK FROM EQUIPMENT AREA TO (3) PROPOSED DC-6, TYP. (1) DC-6 PER SECTOR
- REMOVE (4) EXISTING RRUW, TYPICAL (2) PER SECTOR
- REMOVE (1) EXISTING DUS41 AND REPLACE WITH (2) PROPOSED S216
- REUSE (1) EXISTING XMU AND ADD (1) PROPOSED XMU
- REMOVE (2) EXISTING V1 CHASSIS AND REPLACE WITH (2) PROPOSED V2 CHASSIS
- SWAP EXISTING STRUCTURAL ANTENNA FRAME MEMBERS WITH STEEL ANGLES, SECTORS 'A' & 'C'

DRAWN BY: SLM / JT  
 CHECKED BY: JO

REV	DATE	DESCRIPTION
2	4/23/18	EME REPORT
1	5/18/18	100% CDs
0	5/11/18	100% CDs

license:

It is a violation of law for any persons, unless they are acting under the direction of a licensed professional engineer, to alter this document

Issued For:

**CCL05258**  
 HARBOR BLVD & O'NEILL AVE  
 333 O'NEILL AVENUE  
 BELMONT, CA 94002

Sheet Title:

**TITLE SHEET**

Sheet Number:

**T-1**

**SITE INFORMATION**

PROPERTY OWNER:  
 PSA INSTITUTIONAL PARTNERS, L.P.  
 701 WESTERN AVE  
 GLENDALE, CA 91201

JURISDICTION: COUNTY OF SAN MATEO  
 A.P.N.: 016-010-100  
 CURRENT ZONING: C-1  
 EXISTING USE: COMMUNICATIONS FACILITY  
 PROPOSED USE: COMMUNICATIONS FACILITY  
 LATITUDE (NAD 83): 37.522405  
 37° 31' 20.658" N  
 LONGITUDE (NAD 83): -122.268358  
 -122° 16' 06.668" W

ACCESSIBILITY REQUIREMENTS: FACILITY IS UNMANNED AND NOT FOR HUMAN HABITATION. ACCESSIBILITY IS NOT REQUIRED PER CBC2016, SECTION 11B-203.4 (LIMITED ACCESS SPACE)

POWER AGENCY:  
 PG&E  
 PH: (800) 743-5000  
 TELEPHONE AGENCY:  
 AT&T

RFD5 VERSION: 3.00  
 DATE: 04/19/17  
 DATE UPDATED: 02/20/18

**GENERAL CONTRACTOR NOTES:**

DO NOT SCALE DRAWINGS

THESE PLANS ARE FORMATTED TO BE FULL SIZE AT 24" X 36". CONTRACTORS SHALL VERIFY ALL PLANS AND EXISTING DIMENSIONS AND CONDITIONS ON THE JOB SITE AND SHALL IMMEDIATELY NOTIFY THE ARCHITECT/ENGINEER IN WRITING OF ANY DISCREPANCIES BEFORE PROCEEDING WITH THE WORK OR MATERIAL ORDERS OR BE RESPONSIBLE FOR THE SAME.

**GENERAL NOTES**

THE FACILITY IS UNMANNED AND NOT FOR HUMAN HABITATION. A TECHNICIAN WILL VISIT THE SITE AS REQUIRED FOR ROUTINE MAINTENANCE. THE PROJECT WILL NOT RESULT IN ANY SIGNIFICANT DISTURBANCE OR EFFECT ON DRAINAGE; NO SANITARY SEWER SERVICE, POTABLE WATER, OR TRASH DISPOSAL IS REQUIRED AND NO COMMERCIAL SIGNAGE IS PROPOSED.

**STATEMENTS**

STRUCTURAL ANALYSIS IS NOT WITHIN THE SCOPE OF WORK CONTAINED IN THESE DRAWINGS SET. FOR ANALYSIS OF EXISTING AND/OR PROPOSED COMPONENTS, REFER TO STRUCTURAL ANALYSIS PROVIDED UNDER SEPARATE COVER.

ANTENNA MOUNT ANALYSIS IS NOT WITHIN THE SCOPE OF WORK CONTAINED IN THIS DRAWING SET. FOR ANALYSIS OF MOUNT TO SUPPORT EXISTING AND/OR PROPOSED EQUIPMENT, REFER TO ANTENNA MOUNT STRUCTURAL ANALYSIS PROVIDED UNDER SEPARATE COVER.

**DRIVING DIRECTIONS**

DIRECTIONS FROM AT&T OFFICE: 5001 EXECUTIVE PKWY, SAN RAMON CA 94583

- HEAD NORTHEAST ON BISHOP DRIVE TOWARD SUNSET DRIVE
- TURN RIGHT ONTO SUNSET DRIVE
- TURN RIGHT ON BOLLINGER CANYON ROAD
- MERGE ONTO I-580 W TOWARD DUBLIN BLVD/OAKLAND
- LEFT AT FORK TO CONTINUE ON I-238 N
- TAKE EXIT 15A FOR I-880 S TOWARD SAN JOSE/SAN MATEO BRIDGE
- MERGE ONTO I-880 S
- TAKE EXIT 13A TO MERGE ONTO US-101 S TOWARD SAN JOSE
- TAKE EXIT 412 FOR RALSTON AVE TOWARD NOIRE DAME DE MAHUR UNIVERSITY
- LEFT AT FORK, FOLLOW SIGNS FOR HARBOR BLVD
- RIGHT AT FORK, FOLLOW SIGNS FOR HARBOR BLVD
- CONTINUE ONTO HARBOR BLVD
- TURN RIGHT ONTO ELMER ST
- TURN RIGHT ONTO O'NEILL AVE
- DESTINATION WILL BE ON THE RIGHT

**SHEET INDEX**

T-1	TITLE SHEET	2
GN-1	GENERAL NOTES	2
GN-2	SITE SIGNAGE	2
A-1	OVERALL SITE PLAN	2
A-2	ENLARGED SITE PLAN & EQUIPMENT PLANS	2
A-3	RF SCHEDULE	2
A-3.1	EXISTING & PROPOSED ANTENNA PLANS	2
A-4	NORTHWEST ELEVATIONS	2
A-5	SOUTHWEST ELEVATIONS	2
D-1	DETAILS	2
D-2	DETAILS	2
RF-1	PLUMBING DIAGRAM	2
EME-1	EME SIGNAGE LOCATION PLAN	2
G-1	GROUNDING PLANS & NOTES	2
G-2	GROUNDING DETAILS & NOTES	2

**PDC Corporation**  
 As-built 01/18/2018  
 Signed by: *Janelle Capitan*


 






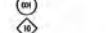



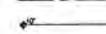
 




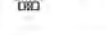




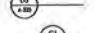





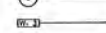




 


- GENERAL CONSTRUCTION NOTES:**
- PLANS ARE INTENDED TO BE DIAGRAMMATIC OUTLINE ONLY, UNLESS NOTED OTHERWISE. THE WORK SHALL INCLUDE FURNISHING MATERIALS, EQUIPMENT, APPURTENANCES AND LABOR NECESSARY TO COMPLETE ALL INSTALLATIONS AS INDICATED ON THE DRAWINGS.
  - THE CONTRACTOR SHALL OBTAIN, IN WRITING, AUTHORIZATION TO PROCEED BEFORE STARTING WORK ON ANY ITEM NOT CLEARLY DEFINED OR IDENTIFIED BY THE CONTRACT DOCUMENTS.
  - CONTRACTOR SHALL CONTACT USA (UNDERGROUND SERVICE ALERT) AT (800) 227-2600, FOR UTILITY LOCATIONS, 48 HOURS BEFORE PROCEEDING WITH ANY EXCAVATION, SITE WORK OR CONSTRUCTION.
  - THE CONTRACTOR SHALL INSTALL ALL EQUIPMENT AND MATERIALS IN ACCORDANCE WITH MANUFACTURER'S RECOMMENDATIONS UNLESS SPECIFICALLY INDICATED OTHERWISE, OR WHERE LOCAL CODES OR REGULATIONS TAKE PRECEDENCE.
  - ALL CONSTRUCTION SHALL BE IN ACCORDANCE WITH THE CBC / UBC'S REQUIREMENTS REGARDING EARTHQUAKE RESISTANCE, FOR, BUT NOT LIMITED TO, PIPING, LIGHT FIXTURES, CEILING GRID, INTERIOR PARTITIONS, AND MECHANICAL EQUIPMENT. ALL WORK MUST COMPLY WITH LOCAL EARTHQUAKE CODES AND REGULATIONS.
  - REPRESENTATIONS OF TRUE NORTH, OTHER THAN THOSE FOUND ON THE PLOT OF SURVEY DRAWINGS, SHALL NOT BE USED TO IDENTIFY OR ESTABLISH BEARING OF TRUE NORTH AT THE SITE. THE CONTRACTOR SHALL RELY SOLELY ON THE PLOT OF SURVEY DRAWING AND ANY SURVEYOR'S MARKINGS AT THE SITE FOR THE ESTABLISHMENT OF TRUE NORTH, AND SHALL NOTIFY THE ARCHITECT / ENGINEER PRIOR TO PROCEEDING WITH THE WORK IF ANY DISCREPANCY IS FOUND BETWEEN THE VARIOUS ELEMENTS OF THE WORKING DRAWINGS AND THE TRUE NORTH ORIENTATION AS DEPICTED ON THE CIVIL SURVEY. THE CONTRACTOR SHALL ASSUME SOLE LIABILITY FOR ANY FAILURE TO NOTIFY THE ARCHITECT / ENGINEER.
  - THE BUILDING DEPARTMENT ISSUING THE PERMITS SHALL BE NOTIFIED AT LEAST TWO WORKING DAYS PRIOR TO THE COMMENCEMENT OF WORK, OR AS OTHERWISE STIPULATED BY THE CODE ENFORCEMENT OFFICIAL HAVING JURISDICTION.
  - DO NOT EXCAVATE OR DISTURB BEYOND THE PROPERTY LINES OR LEASE LINES, UNLESS OTHERWISE NOTED.
  - ALL EXISTING UTILITIES, FACILITIES, CONDITIONS, AND THEIR DIMENSIONS SHOWN ON THE PLAN HAVE BEEN PLOTTED FROM AVAILABLE RECORDS. THE ARCHITECT / ENGINEER AND THE OWNER ASSUME NO RESPONSIBILITY WHATSOEVER AS TO THE SUFFICIENCY OR THE ACCURACY OF THE INFORMATION SHOWN ON THE PLANS, OR THE MANNER OF THEIR REMOVAL OR ADJUSTMENT. CONTRACTORS SHALL BE RESPONSIBLE FOR DETERMINING EXACT LOCATION OF ALL EXISTING UTILITIES AND FACILITIES PRIOR TO START OF CONSTRUCTION. CONTRACTORS SHALL ALSO OBTAIN FROM EACH UTILITY COMPANY DETAILED INFORMATION RELATIVE TO WORKING SCHEDULES AND METHODS OF REMOVING OR ADJUSTING EXISTING UTILITIES.
  - CONTRACTOR SHALL VERIFY ALL EXISTING UTILITIES, BOTH HORIZONTAL AND VERTICALLY, PRIOR TO THE START OF CONSTRUCTION. ANY DISCREPANCIES OR DOUBTS AS TO THE INTERPRETATION OF PLANS SHOULD BE IMMEDIATELY REPORTED TO THE ARCHITECT / ENGINEER FOR RESOLUTION AND INSTRUCTION, AND NO FURTHER WORK SHALL BE PERFORMED UNTIL THE DISCREPANCY IS CHECKED AND CORRECTED BY THE ARCHITECT / ENGINEER. FAILURE TO SECURE SUCH INSTRUCTION MEANS CONTRACTOR WILL HAVE WORKED AT HIS/HER OWN RISK AND EXPENSE.
  - ALL NEW AND EXISTING UTILITY STRUCTURES ON SITE AND IN AREAS TO BE DISTURBED BY CONSTRUCTION SHALL BE ADJUSTED TO FINISH ELEVATIONS PRIOR TO FINAL INSPECTION OF WORK.
  - ANY DRAIN AND/OR FIELD TILE ENCOUNTERED / DISTURBED DURING CONSTRUCTION SHALL BE RETURNED TO ITS ORIGINAL CONDITION PRIOR TO COMPLETION OF WORK. SITE LOCATION AND TYPE OF ANY UNDERGROUND UTILITIES OR IMPROVEMENTS SHALL BE ACCURATELY NOTED AND PLACED ON "AS-BUILT" DRAWINGS BY GENERAL CONTRACTOR, AND ISSUED TO THE ARCHITECT / ENGINEER AT COMPLETION OF PROJECT.
  - ALL TEMPORARY EXCAVATIONS FOR THE INSTALLATION OF FOUNDATIONS, UTILITIES, ETC., SHALL BE PROPERLY LAID BACK OR BRACED IN ACCORDANCE WITH CORRECT OCCUPATIONAL SAFETY AND HEALTH ADMINISTRATION (OSHA) REQUIREMENTS.
  - INCLUDE MISC. ITEMS PER AT&T SPECIFICATIONS

A.B. ABOVE	ANCHOR BOLT	DN. FOUNDATION	SCH. SCHEDULE
ABV. ABOVE	ANCHOR BOLT	DO.C. FACE OF CONCRETE	SHF. SHEET
ADCA. ADDITIONAL	ANTENNA CABLE COVER ASSEMBLY	OS. FACE OF MASONRY	SM. SIMILAR
A.F.F. ABOVE FINISHED FLOOR	ADDITIONAL	OS. FACE OF STUD	SPEC. SPECIFICATIONS
A.F.G. ABOVE FINISHED GRADE	ABOVE FINISHED FLOOR	O.W. FACE OF WALL	SQ. SQUARE
ALUM. ALUMINUM	ABOVE FINISHED GRADE	S. FINISH SURFACE	S.S. STAINLESS STEEL
ALT. ALTERNATE	ALUMINUM	FOOT (FEET)	STD. STANDARD
ANT. ANTENNA	ALTERNATE	FOOTING	STL. STEEL
APPRX. APPROXIMATE[LY]	ANTENNA	GROWTH [CABINET]	STRUC. STRUCTURAL
ARCH. ARCHITECT[URAL]	APPROXIMATE[LY]	GAUGE	TEMP. TEMPORARY
AWG. AMERICAN WIRE GAUGE	ARCHITECT[URAL]	GALVANIZED	TRK. THICKNESS
B.L.G. BUILDING	AMERICAN WIRE GAUGE	J.F.F. JUNCTION FLOOR	T.N. TIE NAIL
BLK. BLOCK	BUILDING	N.I. NOT IN SCALE	TOP OF ANTENNA
BLKG. BLOCKING	BLOCK	IGR. INTERIOR	TOP OF CURB
BM. BENCHMARK	BLOCKING	IBRD. ISOLATED	TOP OF FOUNDATION
B.N. BOUNDARY NAILING	BEAM	IDR. HEADER	TOP OF PLATE (PARAPET)
BTWC. BARE TINNED COPPER WIRE	BOUNDARY NAILING	IGR. HANGER	TOP OF STEEL
B.U. BACK-UP CABINET	BARE TINNED COPPER WIRE	IL. HEIGHT	TOP OF WALL
CAB. CABINET	BACK-UP CABINET	OCB. ISOLATED COPPER GROUND BUS	TYP. TYPICAL
CANT. CANTILEVER[ED]	CABINET	N.I. NOT IN SCALE	ULL. UNDER LAY
C.I.P. CASH IN PLACE	CANTILEVER[ED]	NT. NUMBER	UNDO. UNDERGROUNDED
CLG. CEILING	CASH IN PLACE	B.[N] FOUND(S)	UNWR. UNWRITERS LABORATORY
CLR. CLEAR	CEILING	.B. BOLT	VERIF. VERIFY IN FIELD
COL. COLUMN	CLR. CLEAR	.F. FINISH FEET (FOOT)	WIDE (WIDTH)
CONC. CONCRETE	COL. COLUMN	- LONGITUDINAL	WOOD
CONH. CONNECTION[OR]	CONC. CONCRETE	- MACH. MACHINERY	W.P. WEATHERPROOF
CONST. CONTINUOUS	CONH. CONNECTION[OR]	- MAX. MAXIMUM	WT. WEIGHT
CONT. CONTINUOUS	CONST. CONTINUOUS	- M.B. MACHINE BOLT	C CENTERLINE
D DBL. DOUBLE	CONT. CONTINUOUS	- MCH. MECHANICAL	P PLATE, PROPERTY LINE
DEPT. DEPARTMENT	D DBL. DOUBLE	- MFR. MANUFACTURER	
D.F. DOUGLAS FIR	DEPT. DEPARTMENT	- MIN. MINIMUM	
DIA. DIAGONAL	D.F. DOUGLAS FIR	- MISC. MISCELLANEOUS	
DWG. DRAWING[S]	DIA. DIAGONAL	- MET. METAL	
DWL. DOWEL[S]	DWG. DRAWING[S]	- NEW NEW	
E.A. EACH	DWL. DOWEL[S]	- NO.[F] NUMBER	
EL. ELEVATION	E.A. EACH	- N.S. NOT TO SCALE	
ELEC. ELECTRICAL	EL. ELEVATION	- O.C. ON CENTER	
ELEV. ELEVATOR	ELEC. ELECTRICAL	- OPNG. OPENING	
ENG. ENGINEER	ELEV. ELEVATOR	- PCS PERSONAL COMMUNICATION	
EQ. EQUAL	ENG. ENGINEER	- PLY. PLYWOOD	
EXP. EXPANSION	EQ. EQUAL	- PRC. POWER PROTECTION CABINET	
EXT. EXISTING	EXP. EXPANSION	- PRC. PRIMARY RACK CABINET	
FAB. FABRICATION[OR]	EXT. EXISTING	- P.S.F. POUNDS PER SQUARE FOOT	
F.F. FINISH FLOOR	FAB. FABRICATION[OR]	- P.S.I. POUNDS PER SQUARE INCH	
F.G. FINISH GRADE	F.F. FINISH FLOOR	- P.T. PRESSURE TREATED	
FR. FINISH GRADE	F.G. FINISH GRADE	- PWR. POWER [CABINET]	
FR. FINISH GRADE	FR. FINISH GRADE	- QTY. QUANTITY	
FLR. FLOOR	FR. FINISH GRADE	- RAD.[R] RADIUS	
	FLR. FLOOR	- REF. REFERENCE	
		- REIN.F. REINFORCEMENT[ING]	
		- REQ'D. REQUIRED	
		- RGS. RIGID GALVANIZED STEEL	


- APPLICABLE CODES, REGULATIONS AND STANDARDS:**
- SUBCONTRACTOR'S WORK SHALL COMPLY WITH ALL APPLICABLE NATIONAL, STATE, AND LOCAL CODES AS ADOPTED BY THE LOCAL AUTHORITY HAVING JURISDICTION [A.H.] FOR THE LOCATION.
  - THE EDITION OF THE ADOPTED CODES AND STANDARDS IN EFFECT ON THE DATE OF CONTRACT AWARD SHALL GOVERN THE DESIGN.
  - SUBCONTRACTOR'S WORK SHALL COMPLY WITH THE LATEST EDITION OF THE FOLLOWING STANDARDS:
    - AMERICAN CONCRETE INSTITUTE (ACI) 318, BUILDING CODE REQUIREMENTS FOR STRUCTURAL CONCRETE
    - AMERICAN INSTITUTE OF STEEL CONSTRUCTION (AISC), MANUAL OF STEEL CONSTRUCTION, ASD, NINTH EDITION
    - TELECOMMUNICATIONS INDUSTRY ASSOCIATION (TIA) 222-G, STRUCTURAL STANDARD FOR STRUCTURAL ANTENNA TOWER AND ANTENNA SUPPORTING STRUCTURES
    - INSTITUTE FOR ELECTRICAL AND ELECTRONICS ENGINEERS (IEEE) B1, GUIDE FOR MEASURING EARTH RESISTIVITY, GROUND IMPEDANCE, AND EARTH SURFACE POTENTIALS OF A GROUND SYSTEM IEEE 1100 (1999) RECOMMENDED PRACTICE FOR POWERING AND GROUNDING OF ELECTRICAL EQUIPMENT.
  - IEEE C62.41, RECOMMENDED PRACTICES ON SURGE VOLTAGES IN LOW VOLTAGE AC POWER CIRCUITS (FOR LOCATION CATEGORY "C3" AND "B" HIGH SYSTEM EXPOSURE)
  - TIA 407 COMMERCIAL BUILDING GROUNDING AND BONDING REQUIREMENTS FOR TELECOMMUNICATIONS TELCORDIA GR-63 NETWORK
  - EQUIPMENT BUILDING SYSTEM (EBS): PHYSICAL PROTECTION
  - TELCORDIA GR-347 GENERAL OFFICE POWER WIRING
  - TELCORDIA GR-1275 GENERAL INSTALLATION REQUIREMENTS
  - TELCORDIA GR-1503 COAXIAL CABLE CONNECTIONS
  - ANY AND ALL OTHER LOCAL & STATE LAWS AND REGULATIONS
  - FOR ANY CONFLICTS BETWEEN SECTIONS OF LISTED CODES AND STANDARDS REGARDING MATERIAL, METHODS OF CONSTRUCTION, OR OTHER REQUIREMENTS, THE MOST RESTRICTIVE SHALL GOVERN. WHERE THERE IS CONFLICT BETWEEN A GENERAL REQUIREMENT AND A SPECIFIC REQUIREMENT, THE SPECIFIC REQUIREMENT SHALL GOVERN.

**SYMBOLS LEGEND:**

	B.O.G. SECTION		GROUT OR PLASTER
	V'ALL SECTION		(B) BRICK
	ETAIL		(M) MASONRY
	E ELEVATION		CONCRETE
	E DOOR SYMBOL		EARTH
	V WINDOW SYMBOL		GRAVEL
	T-UP PANEL MARK		PLYWOOD
	PROPERTY LINE		SAND
	CENTERLINE		PLYWOOD
	ELEVATION DATUM		(S) STEEL
	RID/COLUMN LINE		MATCH LINE
	KEYNOTE, DIMENSION ITEM		GROUND CONDUCTOR
	KEYNOTE, CONSTRUCTION ITEM		OVERHEAD SERVICE CONDUCTORS
	V ALL TYPE MARK		TELEPHONE CONDUIT
	ROOM NAME		POWER CONDUIT
	ROOM NUMBER		COAXIAL CABLE
			CHAIN LINK FENCE
			WOOD FENCE
			(A) ANTENNA
			(D) DC SURGE SUPPRESSION
			(E) EQUIPMENT


**PDC Corporation**  
 As-built 9/19/2018  
 Signed by: *Janelle Espinoza*

PREPARED FOR



5001 E EXCURSION PKWY,  
SAN RAMON CA 94583

Vendor:



2030 MAIN STREET, SUITE 200  
RYLE, CALIFORNIA 92614


At&T Site ID:

**CCL05258**

DRAWN BY: SLA / JY  
 CHECKED BY: JO

REV	DATE	DESCRIPTION
2	6/23/18	EME REPORT
1	5/18/18	100% CDs
0	5/1/18	100% CDs

Licensee:



If a violation of law for any person, unless they are acting under the direction of a licensed professional engineer, to alter this document.

Issued for:

**CCL05258**

HARBOR BLVD  
& O'NEILL AVE  
333 O'NEILL AVENUE  
BELMONT, CA 94002

Sheet Title:

**GENERAL NOTES**

Sheet Number:

**GN-1**

This Site Operated by:  
**AT&T MOBILITY**  
 2600 CAMINO RAMON, #4750FF  
 SAN RAMON, CA 94583  
 IN CASE OF FIRE AND THE NEED FOR SHUTDOWN  
 TO DEACTIVATE ANTENNAS CALL THE  
 FOLLOWING NUMBER:  
 For 24 Hour Emergency Contact and Access Please Call:  
 (925)932-6667

Reference Site#: CCL05258  
 Site Address: 333 O'NEILL AVENUE BELMONT, CA 94002

10 FENCED COMPOUND SIGNAGE  
N.T.S.

**DANGER**

**NO TRESPASSING**

9 FENCED COMPOUND SIGNAGE  
N.T.S.

**NOTICE**

**AUTHORIZED PERSONNEL ONLY**

8 DOOR / EQUIPMENT SIGN  
N.T.S.

0  
3 2  
ACID

7 NFPA HAZARD SIGN  
N.T.S.

INFORMATION

Federal Communications Commission  
 Tower Registration Number

1 2 3 4 5 6 7

Placed in accordance with Federal Communications  
 Commission rules and antenna tower registration  
 47CFR 17.46g

6 FCC ASR SIGNAGE  
N.T.S.

Property of AT&T

**Authorized Personnel Only**

No Trespassing  
 Violators will be Prosecuted

In case of emergency, or prior to performing  
 maintenance on this site, call \_\_\_\_\_  
 and reference cell site number \_\_\_\_\_

5 GATE SIGNAGE  
N.T.S.

Property of AT&T

**Authorized Personnel Only**

In case of emergency, or prior to performing  
 maintenance on this site, call \_\_\_\_\_  
 and reference cell site number \_\_\_\_\_

4 SHELTER / CABINET DOORS SIGNAGE  
N.T.S.

8"

INFORMATION

ALL INFORMATION MUST BE BAKED W/ENAMEL W/ UV PROTECTIVE COATING OVER THE FACE OF THE SIGN.

ACTIVE ANTENNAS ARE MOUNTED  
 ON THE OUTSIDE FACE OF THIS BUILDING

INFORMATION SIGN 1-2

ON THIS STRUCTURE

STAY BACK A MINIMUM OF 3 FEET FROM THESE ANTENNAS

CONTACT AT&T MOBILITY AT 800-630-2027 & FOLLOW THE INSTRUCTIONS PROVIDED TO PERFORMING ANY MAINTENANCE OR REPAIRS TO THESE ANTENNAS.

THIS IS AT&T MOBILITY SITE

12"

INFORMATION SIGN 1-1  
 SCALE: 1/2" = 1'

INFORMATION SIGN 1-1  
SCALE: 1/2" = 1'

5"

INFORMATION

ACTIVE ANTENNAS ARE MOUNTED  
 ON THE OUTSIDE FACE OF THIS BUILDING

INFORMATION SIGN 1-2

ON THIS STRUCTURE

STAY BACK A MINIMUM OF 3 FEET FROM THESE ANTENNAS

CONTACT AT&T MOBILITY AT 800-630-2027 & FOLLOW THE INSTRUCTIONS PROVIDED TO PERFORMING ANY MAINTENANCE OR REPAIRS TO THESE ANTENNAS.

THIS IS AT&T MOBILITY SITE

7"

INFORMATION SIGN 1-2  
 SCALE: 3/4" = 1'

INFORMATION SIGN 1-2  
SCALE: 3/4" = 1'

2"

1"

AT&T

INFORMATION SIGN 1-3  
 SCALE: 1/4" = 1'

1-1/2"

24"

INFORMATION SIGN 1-4  
 SCALE: 3/16" = 1'

INFORMATION SIGN 1-4  
SCALE: 3/16" = 1'

1. CONTRACTOR SHALL INSTALL ALL INFORMATION SIGNAGE IN ACCORDANCE W/ AT&T WIRELESS DOCUMENT #03-0074, RF EXPOSURE POLICY AND RF SAFETY COMPLIANCE PROGRAM, LATEST EDITION.

2. FABRICATION:

\*SIGN 1-1: ENTRANCE DOOR, SEE DETAIL 1A, THIS SHEET

SIGN 1-1: TO BE MADE ON THE 50 MIL ALUMINUM SHEETING (SIZE B INCHES BY 12 INCHES) W/ FOUR (4) 1/4 INCH MOUNTING HOLES, ONE EACH CORNER OF THE SIGN FOR MOUNTING W/ HARDWARE W/ THE WR-95. THE MAIN BACKGROUND COLOR IS TO BE WHITE FRONT & BACK W/ BLACK LETTERING.

THE INFORMATION BAND SHALL BE 1.2 INCH SOLID GREEN BAND W/ 0.5 INCH HIGH BLACK LETTERING. THE BODY TEXT SHALL BE IN BLACK LEFT 90° W/ 0.2 INCH HIGH LETTERS. THE REF LINE SHALL BE 1/4 INCH LEFT 90°

THE PLACEMENT OF TEXT SHALL BE DONE IN A MANNER THAT WILL PERMIT READING FROM A DISTANCE OF APPROXIMATELY 6 FEET IN FRONT OF THE SIGN.

3 INFORMATION SIGNAGE  
N.T.S.

NOTE:

1. CONTRACTOR SHALL INSTALL ALL INFORMATION SIGNAGE IN ACCORDANCE W/ AT&T WIRELESS DOCUMENT #03-0074, RF EXPOSURE POLICY AND RF SAFETY COMPLIANCE PROGRAM, LATEST EDITION.

2. CONTRACTOR SHALL CONTACT AT&T R-FISC FOR INFORMATION ON LEVELS AND INSTRUCTIONS ON LEVEL AND LOCATION OF SIGNAGE

ALL PAINT WILL BE BAKED W/ENAMEL W/ UV PROTECTIVE COATING OVER THE FACE OF THE SIGN.

\*SIGN 1-2: POLE, SEE DETAIL 1B, THIS SHEET

SIGN 2 MUST BE A NON METALLIC LABEL W/ AN ADHESIVE BACKING, THE LABEL SHALL BE MADE USING VINYL OR SIMILAR WEATHERPROOF MATERIAL. THE LABEL SHALL BE APPROXIMATELY 507 INCHES W/ A WHITE BACKGROUND AND BLACK LETTERING. THE GREEN BAND SHALL BE 1.375 INCH IN HEIGHT & THE LETTERING SHALL BE BLACK W/ 0.25 INCH HIGH LETTERS. THE TEXT LETTERING SHALL BE BLACK W/ 1/4 INCH HIGH LETTERS. UV PROTECTION SHALL BE PLACED OVER THE FRONT OF THE LABEL.

\*SIGN 1-3: BACK OF ANTENNAS, SEE DETAIL 1C & 3, THIS SHEET

\*SIGN 3 IS A 1 INCH X 2 INCH PANEL THAT CAN BE APPLIED TO THE BACK OR SIDE OF AN ANTENNA TO IDENTIFY IT AS AN AT&T ANTENNA.

\*SIGN 1-4: SIDE OF ANTENNAS, SEE DETAIL 1D & 3, THIS SHEET

SIGN 4 IS MADE FROM TRANSPARENT MATERIAL 1-1/2 INCHES WIDE & 24 INCHES LONG. THE LETTERING IS TO BE BLACK W/ 1/4 INCH LETTERING IN A VERTICAL COLUMN. THE SPACING BETWEEN WORDS MUST BE SUCH THAT IT IS EASILY READ & FILLS THE LENGTH OF THE SIGN.

**WARNING**

Beyond This Point you are entering a controlled area where RF Emissions exceed the FCC Controlled Exposure limits  
 Failure to obey all posted signs and site guidelines could result in serious injury

Rev. FCC 4/27/18 1.1307(5)

2 WARNING, CAUTION AND NOTICE SIGN  
N.T.S.

**CAUTION**

Beyond This Point you are entering a controlled area where RF Emissions may exceed the FCC Controlled Exposure limits  
 Obey all posted signs and site guidelines for working in an RF environment

Rev. FCC 4/27/18 1.1307(5)

**NOTICE**

Beyond This Point you are entering an area where RF Emissions may exceed the FCC General Population Exposure Limits  
 Follow all posted signs and site guidelines for working in an RF environment

Rev. FCC 4/27/18 1.1307(5)

**SIGNAGE AND STRIPING INFORMATION**

- THE FOLLOWING INFORMATION IS A GUIDELINE W/ RESPECT TO PREVAILING STANDARDS LIMITING HUMAN EXPOSURE TO RADIO FREQUENCY ENERGY AND SHOULD BE USED AS SUCH. IF THE SITE'S EMF REPORT OR ANY LOCAL, STATE OR FEDERAL GUIDELINES OR REGULATIONS SHOULD BE IN CONFLICT W/ ANY PART OF THESE NOTES OR PLANS, THE MORE RESTRICTIVE GUIDELINE OR REGULATION SHALL BE FOLLOWED AND OVERRIDE THE LESSER.
- THE PUBLIC LIMIT OF RF EXPOSURE ALLOWED BY AT&T IS 1mW/cm<sup>2</sup> AND THE OCCUPATIONAL LIMIT OF RF EXPOSURE ALLOWED BY AT&T IS 5mW/cm<sup>2</sup>
- IF THE BOTTOM OF THE ANTENNA IS MOUNTED (8) EIGHT FEET ABOVE THE GROUND OR WORKING PLATFORM LINE OF THE PERSONAL COMMUNICATION SYSTEM (PCS) AND DOES NOT EXCEED THE PUBLIC LIMIT OF RF EXPOSURE LIMIT THEN NO STRIPING OR BARRICADES SHOULD BE NEEDED.
- IF THE PUBLIC LIMIT OF RF EXPOSURE ON THE SITE IS EXCEEDED AND THE AREA IS PUBLICLY ACCESSIBLE (e.g. ROOF ACCESS DOOR THAT CANNOT BE LOCKED, OR FIRE EGRESS) THEN BOTH BARRICADES AND STRIPING SHALL BE PLACED AROUND THE ANTENNAS. THE EXACT EXTENT OF THE BARRICADES AND STRIPING SHALL BE DETERMINED BY THE EMF REPORT FOR THE SITE DONE BEFORE OR SHORTLY AFTER COMPLETION OF SITE CONSTRUCTION. USE THE PLANS AS A GUIDELINE FOR PLACEMENT OF SUCH BARRICADES AND STRIPING.
- IF THE PUBLIC LIMIT OF RF EXPOSURE ON THE SITE IS EXCEEDED AND THE AREA IS PUBLICLY ACCESSIBLE (e.g. ROOF ACCESS DOOR THAT CANNOT BE LOCKED, OR FIRE EGRESS) THEN BOTH BARRICADES AND STRIPING SHALL BE PLACED AROUND THE ANTENNAS. THE EXACT EXTENT OF THE BARRICADES AND STRIPING SHALL BE DETERMINED BY THE EMF REPORT FOR THE SITE DONE BEFORE OR SHORTLY AFTER COMPLETION OF SITE CONSTRUCTION. USE THE PLANS AS A GUIDELINE FOR PLACEMENT OF SUCH BARRICADES AND STRIPING.
- ALL TRANSMIT ANTENNAS REQUIRE A THREE LANGUAGE WARNING SIGN WRITTEN IN ENGLISH, SPANISH, AND CHINESE. THIS SIGN SHALL BE PROVIDED TO THE CONTRACTOR BY THE AT&T CONSTRUCTION PROJECT MANAGER AT THE TIME OF CONSTRUCTION. THE LARGER SIGN SHALL BE PLACED IN PLAIN SIGHT AT ALL ROOF ACCESS LOCATIONS AND ON ALL BARRICADES. THE SMALLER SIGN SHALL BE PLACED ON THE ANTENNA ENCLOSURES IN A MANNER THAT IS EASILY SEEN BY ANY PERSON ON THE ROOF. WARNING SIGNS SHALL COMPLY W/ ANSI Z39.2 COLOR, SYMBOL, AND CONTENT CONVENTIONS. ALL SIGNS SHALL HAVE AT&T'S NAME AND THE COMPANY CONTACT INFORMATION (e.g. TELEPHONE NUMBER) TO ARRANGE FOR ACCESS TO THE RESTRICTED AREAS. THIS TELEPHONE NUMBER SHALL BE PROVIDED TO THE CONTRACTOR BY THE AT&T CONSTRUCTION PROJECT MANAGER AT THE TIME OF CONSTRUCTION.
- PHOTOS OF ALL STRIPING, BARRICADES & SIGNAGE SHALL BE PART OF THE CONTRACTORS CLOSE OUT PACKAGE & SHALL BE TURNED INTO THE AT&T CONSTRUCTION PACKAGE & SHALL BE TURNED INTO THE AT&T CONSTRUCTION PROJECT MANAGER AT THE END OF CONSTRUCTION. STRIPING SHALL BE DONE W/ FADE RESISTANT YELLOW SAFETY PAINT IN A CROSS-HATCH PATTERN AS DETAILED BY THE CONSTRUCTION DRAWINGS. ALL BARRICADES SHALL BE MADE OF AN RF FRIENDLY MATERIAL SO AS NOT TO BLOCK OR INTERFERE W/ THE OPERATION OF THE ANTENNAS. BARRICADES SHALL BE PAINTED W/ FADE RESISTANT YELLOW SAFETY PAINT. THE CONTRACTOR SHALL PROVIDE ALL RF FRIENDLY BARRICADES NEEDED, & SHALL PROVIDE THE AT&T CONSTRUCTION PROJECT MANAGER W/ A DETAILED SHOP DRAWING OF EACH BARRICADE. UPON CONSTRUCTION COMPLETION.

1 GENERAL NOTES  
N.T.S.

PREPARED FOR

5001 EXECUTIVE PKWY.  
 SAN RAMON, CA 94583

Vendor:

2030 MAIN STREET, SUITE 200  
 IRVINE, CALIFORNIA 92614

AT&T Site ID:

**CCL05258**

DRAWN BY: SIM / JY  
 CHECKED BY: JO

REV	DATE	DESCRIPTION
2	6/23/18	EME REPORT
1	5/18/18	100% CDs
0	5/11/18	100% CDs

License:

If a violation of law for any persons, unless they are acting under the direction of a licensed professional engineer, to offer this document

Issued For:

**CCL05258**

HARBOR BLVD  
 O'NEILL AVE  
 333 O'NEILL AVENUE  
 BELMONT, CA 94002

Sheet Title:

**SITE SIGNAGE**


Sheet Number:

**GN-2**

PDC Corporation  
 As-built 8/10/2018  
 Signed by: *Janelle Espinoza*

**THIS IS NOT A SITE SURVEY**

ALL PROPERTY BOUNDARIES, ORIENTATION OF TRUE NORTH AND STREET HALF-WIDTHS HAVE BEEN OBTAINED FROM A TAX PARCEL MAP AND EXISTING DRAWINGS AND ARE APPROXIMATE.

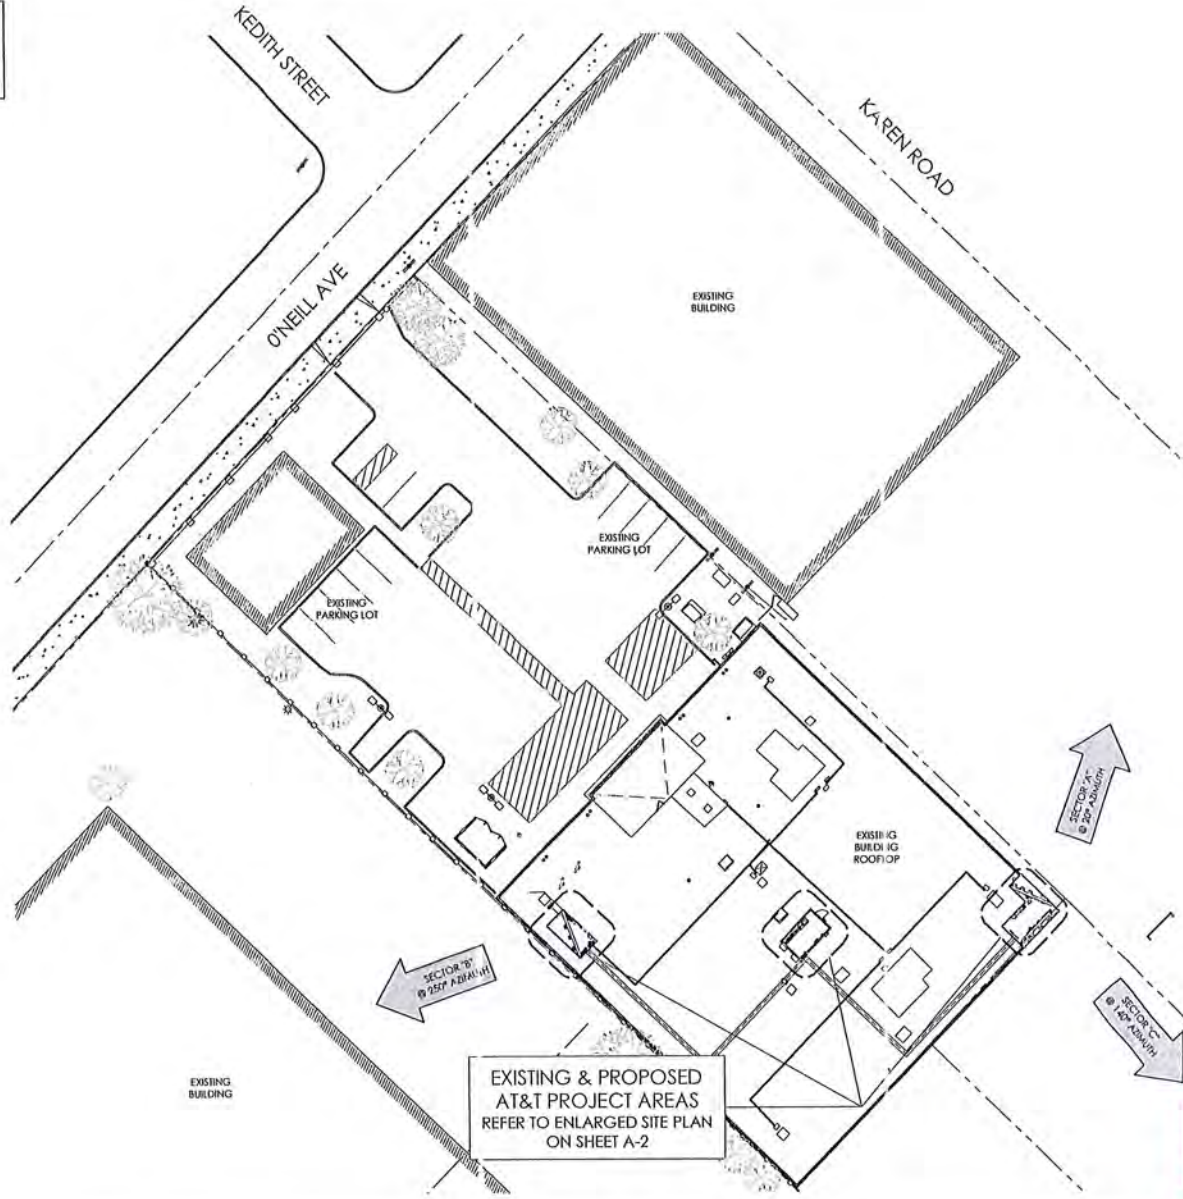

EXISTING & PROPOSED AT&T PROJECT AREAS REFER TO ENLARGED SITE PLAN ON SHEET A-2

PDC Corporation  
As-built 9/19/2018  
Signed by: *Janelle Espitia*

24x36" SCALE: 1" = 20'-0"  
11x17" SCALE: 1" = 40'-0"  
20' 10' 0' 20'



PREPARED FOR

5001 EXECUTIVE PKWY.  
SAN RAMON CA 94583

Vendor:

**J5 INFRASTRUCTURE**  
AZ - CA - CO - ID - IL - IN - MI - NY - UT  
2030 MAIN STREET, SUITE 200  
IRVINE, CALIFORNIA 92614

AT&T Site ID:

**CCL05258**

DRAWN BY: SIM / JY  
CHECKED BY: JO

REV	DATE	DESCRIPTION
2	6/23/18	EME REPORT
1	5/16/18	100% CDs
0	5/11/18	100% CDs

License:

If it is a violation of law for any persons, unless they are acting under the direction of a licensed professional engineer, to offer this document.

Issued For:


**CCL05258**  
HARBOR BLVD & O'NEILL AVE  
333 O'NEILL AVENUE  
BELMONT, CA 94002

Sheet Title:

**OVERALL SITE PLAN**


Sheet Number:

**A-1**

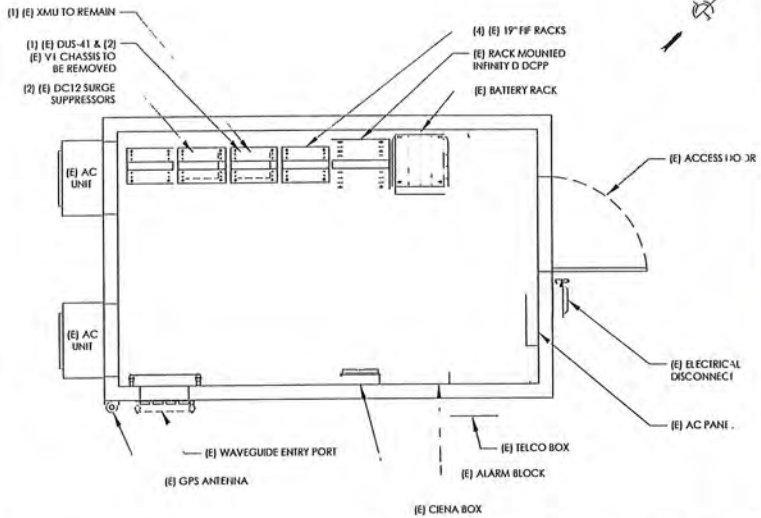


2 EXISTING EQUIPMENT PLAN

20'x36" SCALE: 1/2" = 1'-0"  
 11'x17" SCALE: 1/4" = 1'-0"

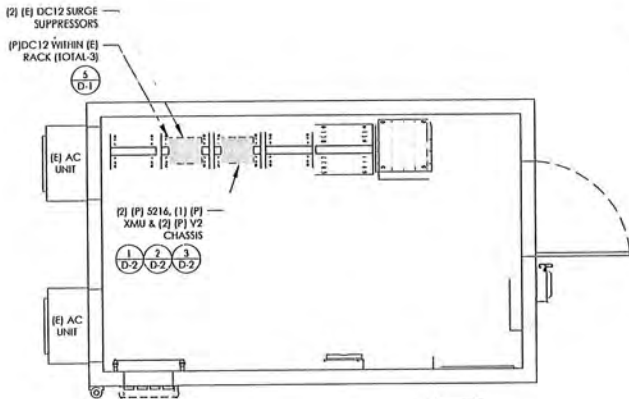

3 PROPOSED EQUIPMENT PLAN

24'x36" SCALE: 1/2" = 1'-0"  
 11'x17" SCALE: 1/4" = 1'-0"

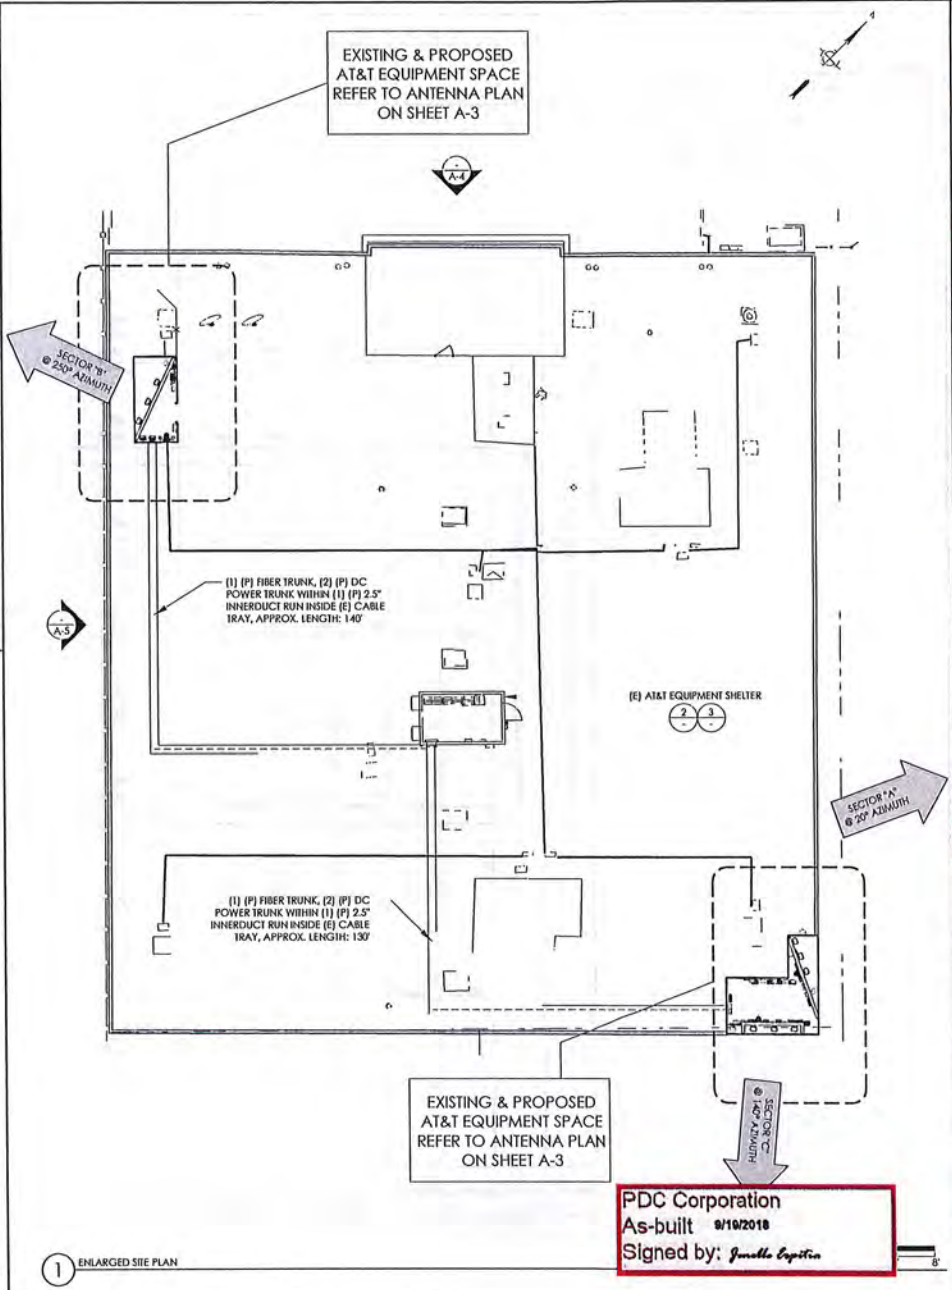

1 ENLARGED SITE PLAN

PREPARED FOR  
  
 5001 EXECUTIVE PARKWAY, SAN RAMON, CA 94583

Vendor:  
  
 2030 MAIN STREET, SUITE 200, IRVINE, CALIFORNIA 92614

AT&T Site ID:  
**CCL05258**

DRAWN BY: SLM / JY  
 CHECKED BY: JO

REV	DATE	DESCRIPTION
2	4/23/18	EME REPORT
1	5/18/18	100% CDS
0	5/11/18	100% CDS

licensor:

It is a violation of law for any person, unless they are acting under the direction of a licensed professional engineer, to alter this document!

Issued For:  
**CCL05258**  
 HARBOR BLVD & O'NEILL AVE  
 333 O'NEILL AVENUE  
 BELMONT, CA 94002

Sheet Title:  
**ENLARGED SITE PLAN & EQUIPMENT PLANS**

Sheet Number:  
**A-2**



**GROUNDING NOTES:**


1. ALL DETAILS ARE SHOWN IN GENERAL TERMS. ACTUAL GROUNDING INSTALLATION REQUIREMENTS AND CONSTRUCTION ACCORDING TO SITE CONDITIONS.
2. ALL GROUNDING CONDUCTORS: #2 AWG SOLID BARE TINNED COPPER WIRE UNLESS OTHERWISE NOTED.
3. GROUND BAR LOCATED IN BASE OF EQUIPMENT WILL BE PROVIDED, FURNISHED AND INSTALLED BY THE VENDOR.
4. ALL BELOW GRADE CONNECTIONS: EXOTHERMIC WELD TYPE, ABOVE GRADE CONNECTIONS: EXOTHERMIC WELD TYPE.
5. GROUND RING SHALL BE LOCATED A MINIMUM OF 24" BELOW GRADE OR 6" MINIMUM BELOW THE FROST LINE.
6. INSTALL GROUND CONDUCTORS AND GROUND ROD MINIMUM OF 1'-0" FROM EQUIPMENT CONCRETE SLAB, SPREAD FOOTING, OR FENCE.
7. EXOTHERMIC WELD GROUND CONNECTION TO FENCE POST: TREAT WITH A COLD GALVANIZED SPRAY.
8. GROUND BARS:
  - A) EQUIPMENT GROUND BUS BAR (EGB) LOCATED AT THE BOTTOM OF ANTENNA POLE/MAST FOR MAKING GROUNDING JUMPER CONNECTIONS TO COAX FEEDER CABLES SHALL BE FURNISHED AND INSTALLED BY ELECTRICAL CONTRACTOR. JUMPERS (FURNISHED BY OWNERS) SHALL BE INSTALLED AND CONNECTED BY ELECTRICAL CONTRACTOR.
9. ALL GROUNDING INSTALLATIONS AND CONNECTIONS SHALL BE MADE BY ELECTRICAL CONTRACTOR.
10. OBSERVE H.E.C. AND LOCAL UTILITY REQUIREMENTS FOR ELECTRICAL SERVICE GROUNDING.
11. GROUNDING ATTACHMENT TO TOWER SHALL BE AS PER MANUFACTURER'S RECOMMENDATIONS OR AT GROUNDING POINTS PROVIDED (2 MINIMUM).
12. IF EQUIPMENT IS IN A C.L. FENCE ENCLOSURE, GROUND ONE CORNER POST AND SUPPORT POSTS OF GATE. IF CHAIN LINK LID IS USED, THEN GROUND LID ALSO.
13. GROUNDING AT PPC CABINET SHALL BE VERTICALLY INSTALLED.
14. ALL GROUNDING FOR ANTENNAS SHALL BE CONNECTED SO THAT IT WILL BY-PASS MAIN BUSS BAR.
15. ALL ENT RINS SHALL BE GROUNDED AND HAVE A BUSHING, NO PVC ABOVE GROUND.
16. USE SEPARATE HOLES FOR GROUNDING AT BUSS BAR. NO "DOUBLE-UP" OF LUGS.
17. POWER AND TELCO CABINETS SHALL BE GROUNDED (BONDED) TOGETHER.
18. NO LBS ALLOWED ON GROUNDING.
19. PROVIDE STAINLESS STEEL CLAMP AND BRASS TAGS ON COAX AT ANTENNAS AND DOGHOUSE.
20. ALL ELECTRICAL AND GROUNDING AT THE CELL SITE SHALL COMPLY WITH THE NATIONAL ELECTRICAL CODE (NEC), NATIONAL FIRE PROTECTION ASSOCIATION (NFPA) 700 (LATEST EDITION), AND MANUFACTURER SPECIFICATION.
21. IF THE AC PANEL IN THE POWER CABINET IS WIRED AS SERVICE ENTRANCE, THE AC SERVICE GROUND CONDUCTOR SHALL BE CONNECTED TO GROUND ELECTRODE SYSTEM. WHEN THE AC PANEL IN THE POWER CABINET IS CONSIDERED A SUB-PANEL, THE GROUND WIRE SHALL BE INSTALLED IN THE AC POWER CONDUIT. THE INSTALLATION SHALL BE PER LOCAL AND NATIONAL ELECTRIC CODE (NFPA-70).
22. EXOTHERMIC WELDING IS RECOMMENDED FOR GROUNDING CONNECTION WHERE PRACTICAL. OTHERWISE, THE CONNECTION SHALL BE MADE USING COMPRESSION TYPE 2 HOLES, LOW BARREL LUGS OR DOUBLE CRIMP CLAMP "C" CLAMP. THE COPPER CABLES SHALL BE COATED WITH ANTI-OXIDANT (COPPER SHIELD) BEFORE MAKING THE CONNECTIONS. THE MANUFACTURER'S TORQUING RECOMMENDATIONS ON THE BOLT ASSEMBLY TO SECURE CONNECTIONS SHALL BE FOLLOWED.
23. THE ANTENNA CABLES SHALL BE GROUNDED AT THE TOP AND BOTTOM OF THE VERTICAL RUN FOR LIGHTNING PROTECTION. THE ANTENNA CABLE SHIELD SHALL BE BONDED TO A COPPER GROUND BUSS AT THE LOWER MOST POINT OF A VERTICAL RUN JUST BEFORE IT BEGINS TO BEND TOWARD THE HORIZONTAL PLANE. WIRE RUNS TO GROUND SHALL BE KEPT AS STRAIGHT AND SHORT AS POSSIBLE. ANTENNA CABLE SHIELD SHALL BE GROUNDED JUST BEFORE ENTERING THE CELL CABINET. ANY ANTENNA CABLES OVER 200 FEET IN LENGTH SHALL ALSO BE EQUIPPED WITH ADDITIONAL GROUNDING AT MID-POINT.

24. ALL GROUNDING CONDUCTORS INSIDE THE BUILDING SHALL BE RUN IN CONDUIT RACEWAY SYSTEM, AND SHALL BE INSTALLED AS STRAIGHT AS PRACTICAL WITH MINOR BENDS TO AVOID OBSTRUCTIONS. THE BENDING RADIUS OF ANY #2 GROUNDING CONDUCTOR IS 8". PVC RACEWAY MAY BE FLEXIBLE OR RIGID. PER THE FIELD CONDITIONS, GROUNDING CONDUCTORS SHALL NOT MAKE CONTACT WITH ANY METALLIC CONDUITS, SURFACES OR EQUIPMENT.
25. PROVIDE PVC SLEEVES WHERE GROUNDING CONDUCTORS PASS THROUGH THE BUILDING WALLS AND FOR CEILINGS.
26. INSTALL GROUND BUSHINGS ON ALL METALLIC CONDUITS AND RIGID TO THE EQUIPMENT GROUND BUSS IN THE PANEL BOARD.
27. GROUND ANTENNA BASES, FRAMES, CABLE RACKS AND OTHER METALLIC COMPONENTS WITH #2 GROUNDING CONDUCTORS AND CONNECT TO INSULATED SURFACE MOUNTED GROUND BARS. CONNECTION DETAILS SHALL FOLLOW MANUFACTURER'S SPECIFICATIONS FOR GROUNDING.
28. ALL PROPOSED GROUNDING CONDUCTORS SHALL BE ROUTED AND CONNECTED TO THE MAIN GROUND BAR OR EXISTING GROUND RING.


4 GROUNDING NOTES  
N.T.S.

**KEY NOTES:**

- 1. [E] ANTENNA GROUND BAR TO BE VERIFIED @ FIELD
  - 2. AWG 2 INSULATED COPPER GROUND WIRE FROM [M] RRUS AND DC6 TO [E] ANTENNA GROUND BAR
  - 3. AWG 4 INSULATED COPPER GROUND WIRE FROM GROUND KIT TO [E] ANTENNA GROUND BAR
- NOTES:  
1. REFER TO TYP. ANTENNA GROUNDING DIAGRAM  
2. [E] GROUND WIRES ARE NOT SHOWN FOR CLARITY

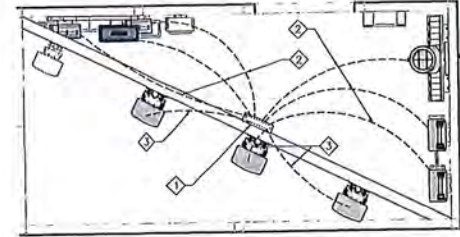

3 ANTENNA GROUNDING PLAN (TYP. PER SECTOR)  
1/2" = 1'-0"

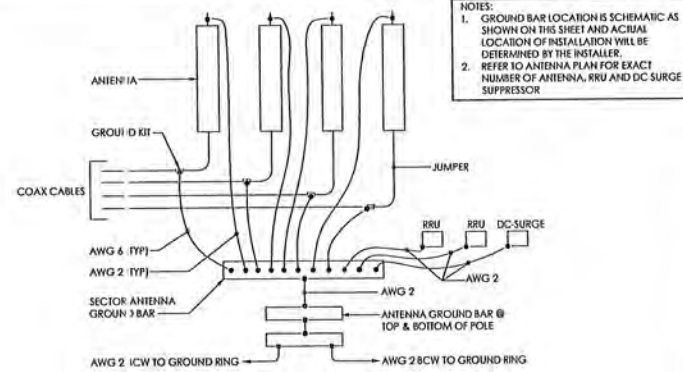

2 TYP. ANTENNA GROUNDING DIAGRAM  
N.T.S.

1 NOT USED

PREPARED FOR



5001 EXECUTIVE Pkwy,  
SAN RAMON, CA 94583

Vendor:



2030 MAIN STREET, SUITE 200  
RYVINE, CALIFORNIA 92614

A&T Site ID:

**CCL05258**

DRAWN BY: SJM / JY

CHECKED BY: JO

REV	DATE	DESCRIPTION
2	6/23/18	EME REPORT
1	5/18/18	100% CDs
0	5/11/18	100% CDs

License:



It is a violation of law for any person, unless they are acting under the direction of a licensed professional engineer, to alter this document.

Issued For:

**CCL05258**

HARBOR BLVD  
& O'NEILL AVE  
333 O'NEILL AVENUE  
BELMONT, CA 94002

Sheet Title:

**GROUNDING PLAN  
& NOTES**




Sheet Number:

**G-1**


PDC Corporation  
As-built 9/19/2018  
Signed by: *Janelle Espinoza*

10 NOT USED  
N.T.S.


- NOTES:
- DO NOT INSTALL CABLE GROUND KIT AT A BEND AND ALWAYS DIRECT GROUND WIRE DOWN TO GROUND BAR
  - GROUNDING KIT SHALL BE TYPE AND PART NUMBER AS SUPPLIED OR RECOMMENDED BY CABLE MFR
  - WEATHER PROOFING SHALL BE TYPE AND PART NUMBER AS SUPPLIED OR RECOMMENDED BY THE CABLE MFR

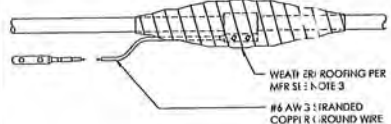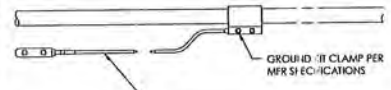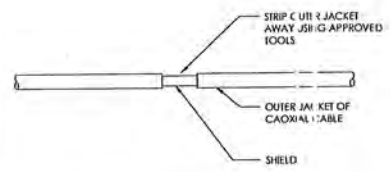

7 GROUND KIT  
N.T.S.

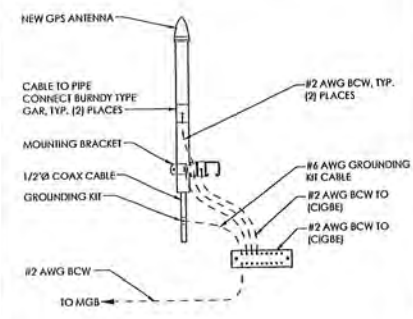


9 GPS ANTENNA GROUNDING  
N.T.S.

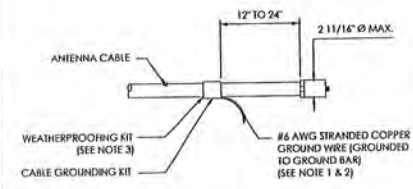


- NOTE:
- DO NOT INSTALL CABLE GROUND KIT AT A BEND AND ALWAYS DIRECT WIRE DOWN TO GROUND BAR.
  - GROUNDING KIT SHALL BE TYPE AND PART NUMBER AS SUPPLIED OR RECOMMENDED BY CABLE MANUFACTURER.
  - WEATHER PROOFING SHALL BE TYPE AND PART NUMBER AS SUPPLIED OR RECOMMENDED BY CABLE MANUFACTURER.

8 CONNECTION OF GROUND KIT TO ANTENNA CABLE  
N.T.S.

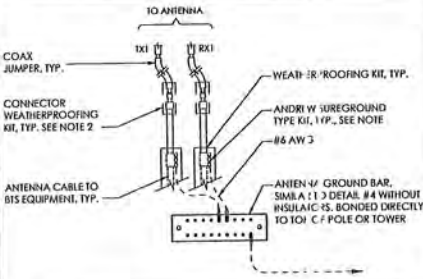


- NOTE:
- DO NOT INSTALL CABLE GROUND KIT AT A BEND AND ALWAYS DIRECT GROUND WIRE DOWN TO ANTENNA GROUND BAR
  - WEATHER PROOFING SHALL BE ANDREW TWO-PART 1: PE KIT. COLD SHRINK SHALL NOT BE USED

6 GROUND CONNECTION TO GROUND BAR  
N.T.S.

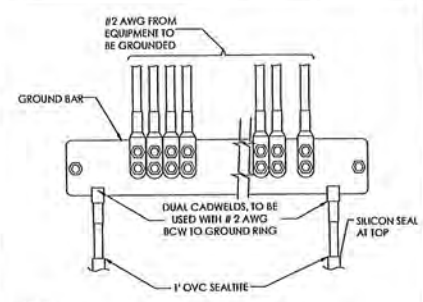

- NOTE:
- CONTRACTOR TO UTILIZE KOPR-SHIELD (TRANS & BETTS) ON ALL LUG CONNECTIONS OR APPROVED EQUAL
  - ALL LUGS TO BE DUAL HOLE LONG BARREL AND CRIMPED TWICE WITH MFR'S RECOMMENDED TOOL

5 GROUND BAR CONNECTION  
N.T.S.

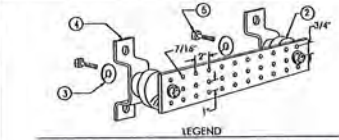


- LEGEND
- COPPER GROUND BAR, 7/16\"/>
  - INSULATORS, NEWTON INSTRUMENT CAT. NO. 3061-4 OR EQUAL
  - 5/8\"/>
  - WALL MOUNTING BRACKET, NEWTON INSTRUMENT CO. CAT NO. A-6054 OR EQUAL
  - 5/8-11 X 1\"/>
  - INSULATORS SHALL BE ELIMINATED WHEN BONDING DIRECTLY TO TOWER/MONOPOLE STRUCTURE. CONNECTION TO TOWER/MONOPOLE STRUCTURE SHALL BE PER MANUFACTURERS RECOMMENDATIONS.

NOTE: ALL HARDWARE SHALL BE STAINLESS STEEL

4 GROUND BAR DETAIL  
N.T.S.

3 NOT USED  
N.T.S.

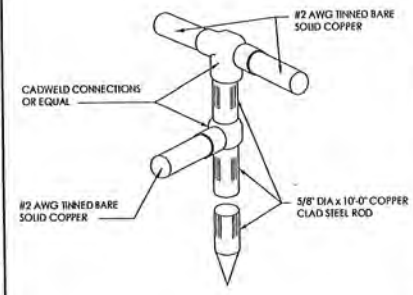

2 GROUND ROD DETAIL  
N.T.S.



1 TYPICAL MECHANICAL CONNECTIONS  
N.T.S.

PDC Corporation  
As-built 07/02/10  
Signed by: *Juanita Espino*

PREPARED FOR

501 EXECUTIVE PENT,  
SAN RAMON CA 94583

Vendor:

2030 MAIN STREET, SUITE 200  
IRVINE, CALIFORNIA 92614

AT&T Site ID:  
**CCL05258**

DRAWN BY: SLW / JY  
CHECKED BY: JO

REV	DATE	DESCRIPTION
2	4/23/18	EME REPORT
1	5/18/18	100% CDs
0	5/11/18	100% CDs

License:

It is a violation of law for any person, unless they are acting under the direction of a licensed professional engineer, to alter this document

Issued For:  
**CCL05258**  
HARBOR BLVD  
& O'NEILL AVENUE  
BELMONT, CA 94002

Sheet Title:  
**GROUNDING DETAILS**

Sheet Number:  
**G-2**

NOTES TO CONTRACTOR:  
 1. CONTRACTOR IS TO REFER TO AT&T'S MOST CURRENT RADIO FREQUENCY DATA SHEET (RFDS) PRIOR TO CONSTRUCTION.  
 2. CABLE LENGTHS WERE DETERMINED BASED ON VISUAL INSPECTION DURING SITE WALK. CONTRACTOR TO VERIFY ACTUAL LENGTH DURING PRE-CONSTRUCTION WALK.  
 3. CONTRACTOR TO VERIFY PORTS HAVE SUFFICIENT ROOM.

NOTE:  
 (E) ANTENNA AZIMUTHS ARE ESTIMATED AND ARE TO BE VERIFIED BY RF.

Position	Antenna					RRU				Additional Antenna Information				Line Information			
	Use	Type		Technology	Proposed	Existing		Proposed		Azimuth		RAD Center		Coax Cables		Power/Fiber	
	Swap/New	Existing	Proposed	Existing		RRU Type	RRU Location	RRU Type	RRU Location	Existing	Propose	Existing	Propose	Existing	Propose	Existing	Propose
ALPHA																	
1	Use Existing	Commscope SBNHH-1D65B	Commscope SBNHH-1D65B	LTE 700 BC / LTE 1900 2x2	LTE 700 BC / LTE 1900 4x4	RRUS11 - 700BC RRUS12 - PCS	TOP TOP	RRUS11 - 700BC RRUS-4415 B25	TOP TOP	20	20	57	57				
2	Swap	Commscope SBNHH-1D65B	Commscope JAHH-65B-R3B v3	LTE WCS	LTE 700 FNET1 / LTE 850 / LTE WCS	RRUS32 B30 WCS	TOP	RRU 4478 B14 RRU 4478 B5 RRUS32 B30 WCS	TOP TOP TOP	20	20	57	57				
3	Swap	Andrew SBNH 1D6565B	Commscope JAHH-65B-R3B v3	UMTS 850	LTE 700 FNET2 / UMTS 850 / LTE AWS	RRUW RRUW	TOP TOP	RRUW RRU 4426 B66 AWS	TOP TOP	20	20	57	57	NONE	NONE		
4	Swap	Andrew SBNH 1D6565B	Commscope JAHH-65B-R3B v3	UMTS 850	LTE 700 DE / UMTS 850	RRUW RRUW	TOP TOP	RRUS-E2 - 700 DE RRUW	TOP TOP	20	20	57	57				
BETA																	
1	Use Existing	Commscope SBNHH-1D65B	Commscope SBNHH-1D65B	LTE 700 BC / LTE 1900 2x2	LTE 700 BC / LTE 1900 4x4	RRUS11 - 700BC RRUS12 - PCS	TOP TOP	RRUS11 - 700BC RRUS-4415 B25	TOP TOP	250	250	45	45				
2	Swap	Commscope SBNHH-1D65B	Commscope JAHH-65B-R3B v3	LTE WCS	LTE 700 FNET1 / LTE 850 / LTE WCS	RRUS32 B30 WCS	TOP	RRU 4478 B14 RRU 4478 B5 RRUS32 B30 WCS	TOP TOP TOP	250	250	45	45				
3	Swap	Andrew SBNH 1D6565B	Commscope JAHH-65B-R3B v3	UMTS 850	LTE 700 FNET2 / UMTS 850 / LTE AWS	RRUW RRUW	TOP TOP	RRUW RRU 4426 B66 AWS	TOP TOP	250	250	45	45	NONE	NONE		
4	Swap	Andrew SBNH 1D6565B	Commscope JAHH-65B-R3B v3	UMTS 850	LTE 700 DE / UMTS 850	RRUW RRUW	TOP TOP	RRUS-E2 - 700 DE RRUW	TOP TOP	250	250	45	45				
GAMMA																	
1	Use Existing	Commscope SBNHH-1D65B	Commscope SBNHH-1D65B	LTE 700 BC / LTE 1900 2x2	LTE 700 BC / LTE 1900 4x4	RRUS11 - 700BC RRUS12 - PCS	TOP TOP	RRUS11 - 700BC RRUS-4415 B25	TOP TOP	140	140	57	57				
2	Swap	Commscope SBNHH-1D65B	Commscope JAHH-65B-R3B v3	LTE WCS	LTE 700 FNET1 / LTE 850 / LTE WCS	RRUS32 B30 WCS	TOP	RRU 4478 B14 RRU 4478 B5 RRUS32 B30 WCS	TOP TOP TOP	140	140	57	57				
3	Swap	Andrew SBNH 1D6565B	Commscope JAHH-65B-R3B v3	UMTS 850	LTE 700 FNET2 / UMTS 850 / LTE AWS	RRUW RRUW	TOP TOP	RRUW RRU 4426 B66 AWS	TOP TOP	140	140	57	57	NONE	NONE		
4	Swap	Andrew SBNH 1D6565B	Commscope JAHH-65B-R3B v3	UMTS 850	LTE 700 DE / UMTS 850	RRUW RRUW	TOP TOP	RRUS-E2 - 700 DE RRUW	TOP TOP	140	140	57	57				

(9) 0.8" dia power trunk cables + (6) 0.4" dia fiber trunk cables  
 (15) 0.8" dia power trunk cables + (9) 0.4" dia fiber trunk cables



Vendor:  
**IS INFRASTRUCTURE**  
 2030 MAIN STREET, SUITE 200  
 IRVINE, CALIFORNIA 92614

AT&T Site ID:  
**CCL05258**

DRAWN BY: SJM / JT  
 CHECKED BY: JO

2	4/23/18	EME REPORT
1	5/18/18	100% CD
0	5/11/18	100% CD
REV	DATE	DESCRIPTION







If it is a violation of law for any persons, unless they are acting under the direction of a licensed professional engineer, to alter this document.

Issued For:  
**CCL05258**  
 HARBOR BLVD  
 & O'NEILL AVE  
 333 O'NEILL AVENUE  
 BELMONT, CA 94002

Sheet Title:  
 RF SCHEDULE

Sheet Number:  
**A-3**

PDC Corporation  
 As-built 9/19/2018  
 Signed by: *Janelle Espinoza*

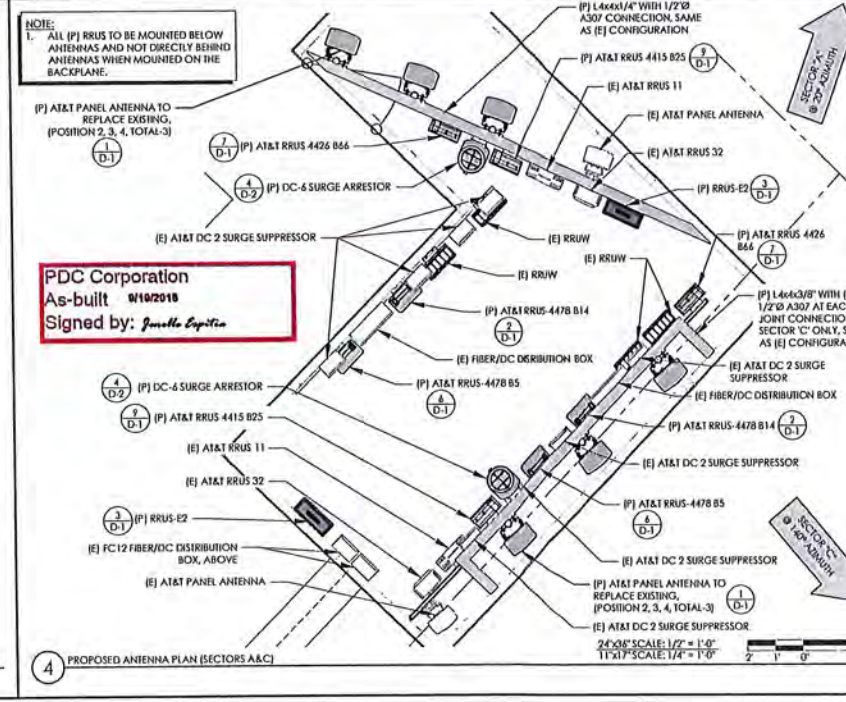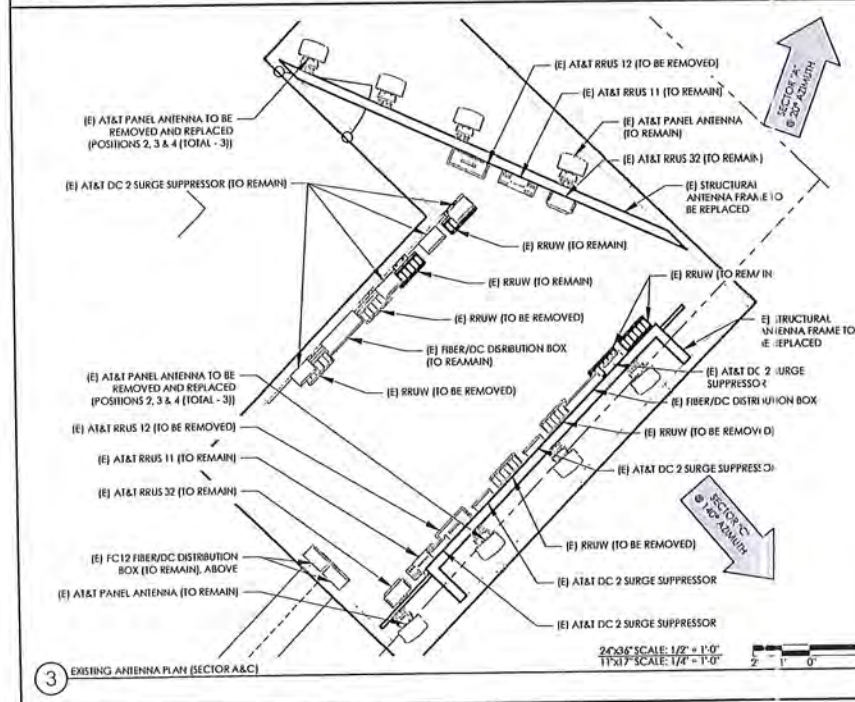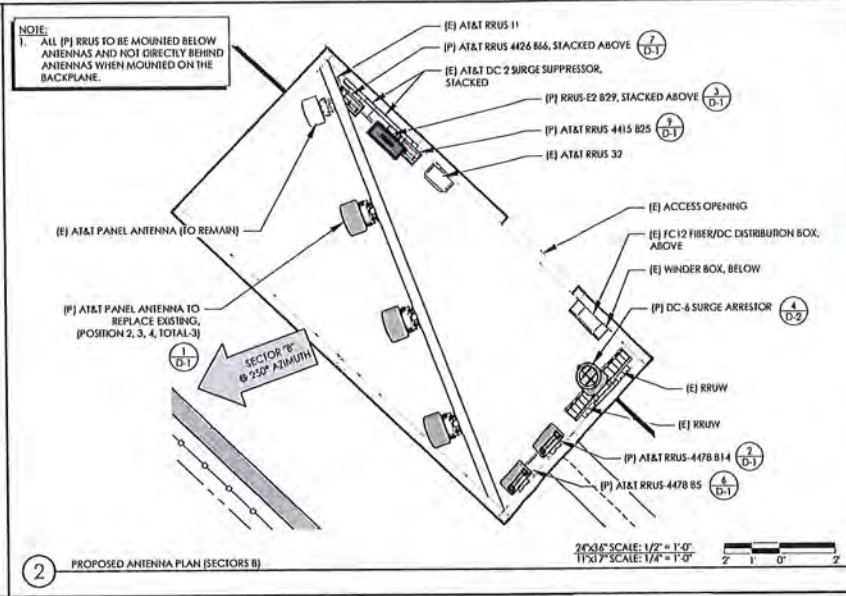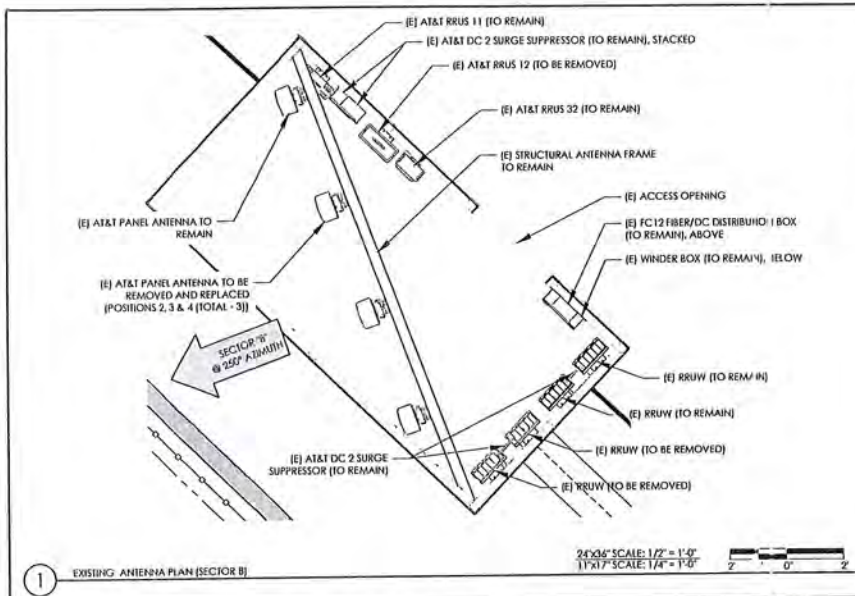

NOTE:  
1. ALL (P) RRU TO BE MOUNTED BELOW ANTENNAS AND NOT DIRECTLY BEHIND ANTENNAS WHEN MOUNTED ON THE BACKPLANE.

NOTE:  
1. ALL (P) RRU TO BE MOUNTED BELOW ANTENNAS AND NOT DIRECTLY BEHIND ANTENNAS WHEN MOUNTED ON THE BACKPLANE.

PDC Corporation  
As-built 01/10/2018  
Signed by: *Jessica Capitan*

PREPARED FOR

5001 EXECUTIVE PKWY,  
SAN RAMON CA 94583

Vendor:

2030 MAIN STREET, SUITE 200  
RYVINE, CALIFORNIA 92614

AT&T Site ID:

**CCL05258**

DRAWN BY: SIM / JY  
CHECKED BY: JO

REV	DATE	DESCRIPTION
2	4/23/18	EME REPORT
1	5/16/18	100% CDs
0	5/11/18	100% CDs

Licensee:

It is a violation of law for any person, unless they are acting under the direction of a licensed professional engineer, to alter this document.


Issued For:

**CCL05258**  
HARBOR BLVD & O'NEILL AVE  
333 O'NEILL AVENUE  
BELMONT, CA 94002



Sheet Title:  
**EXISTING & PROPOSED ANTENNA PLANS**

Sheet Number:  
**A-3.1**



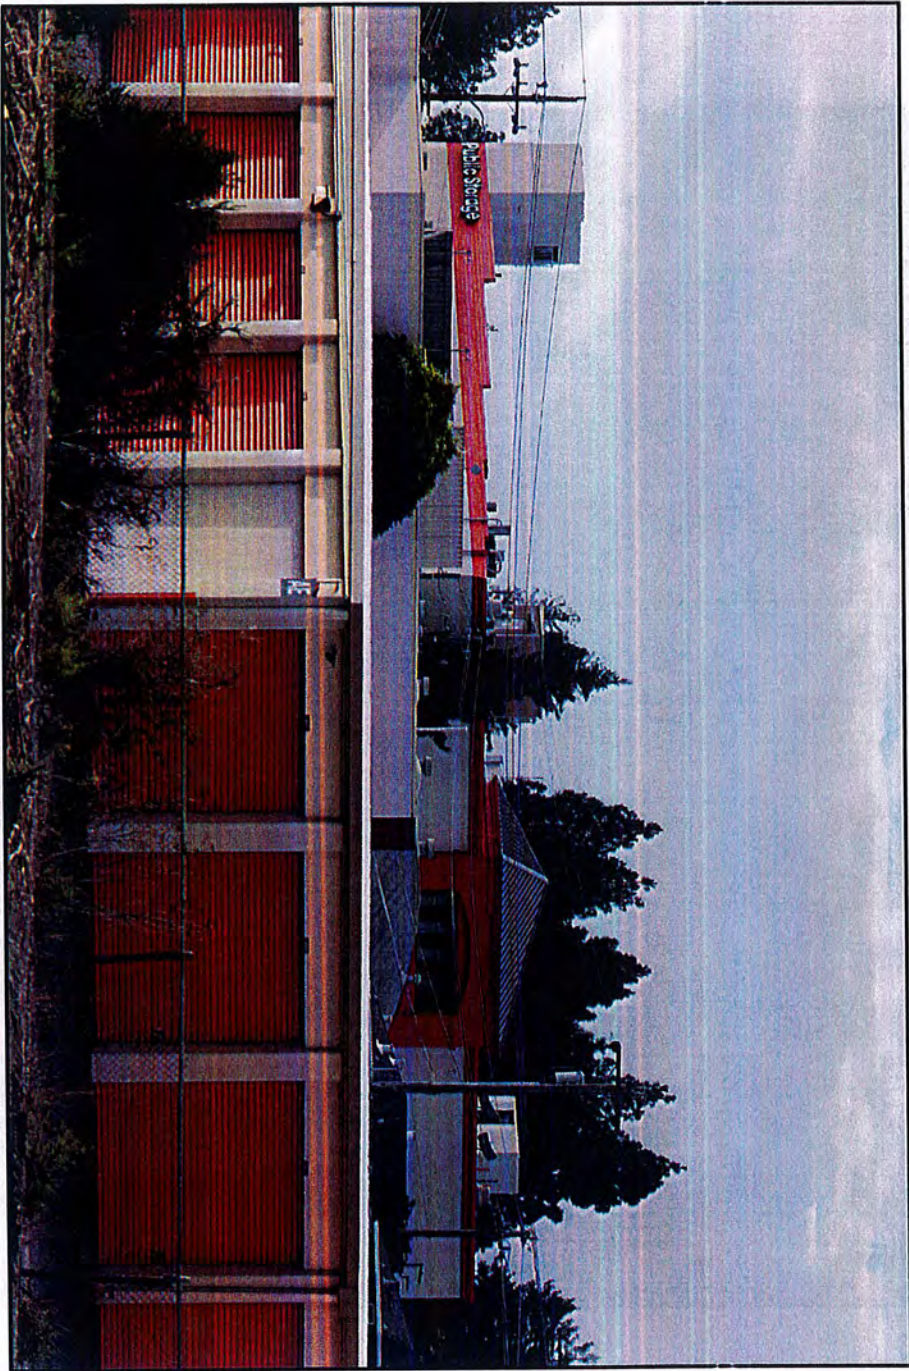



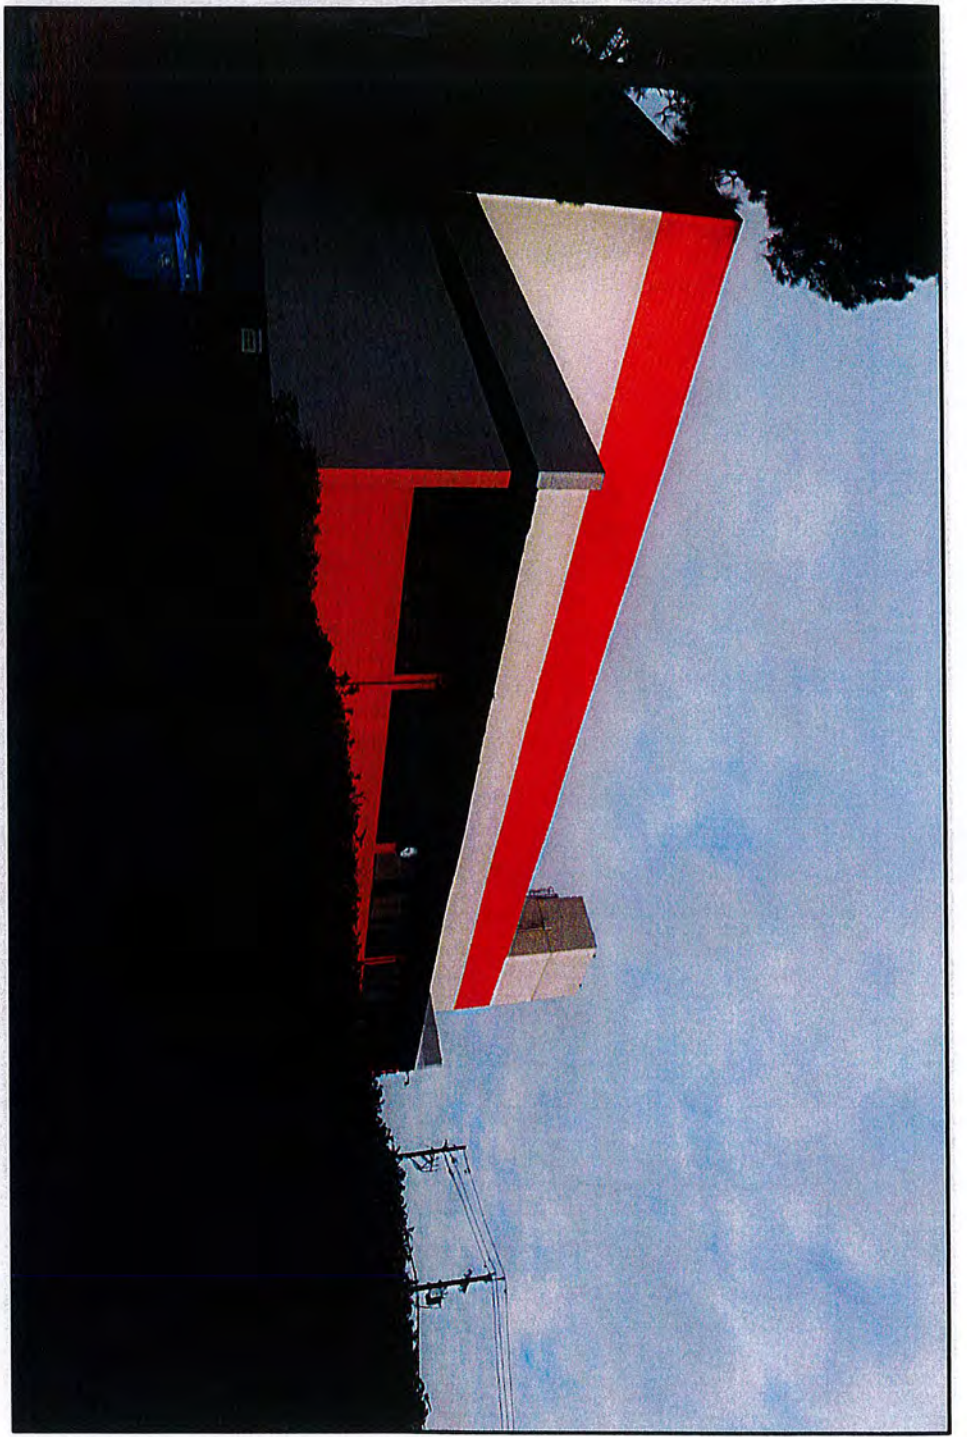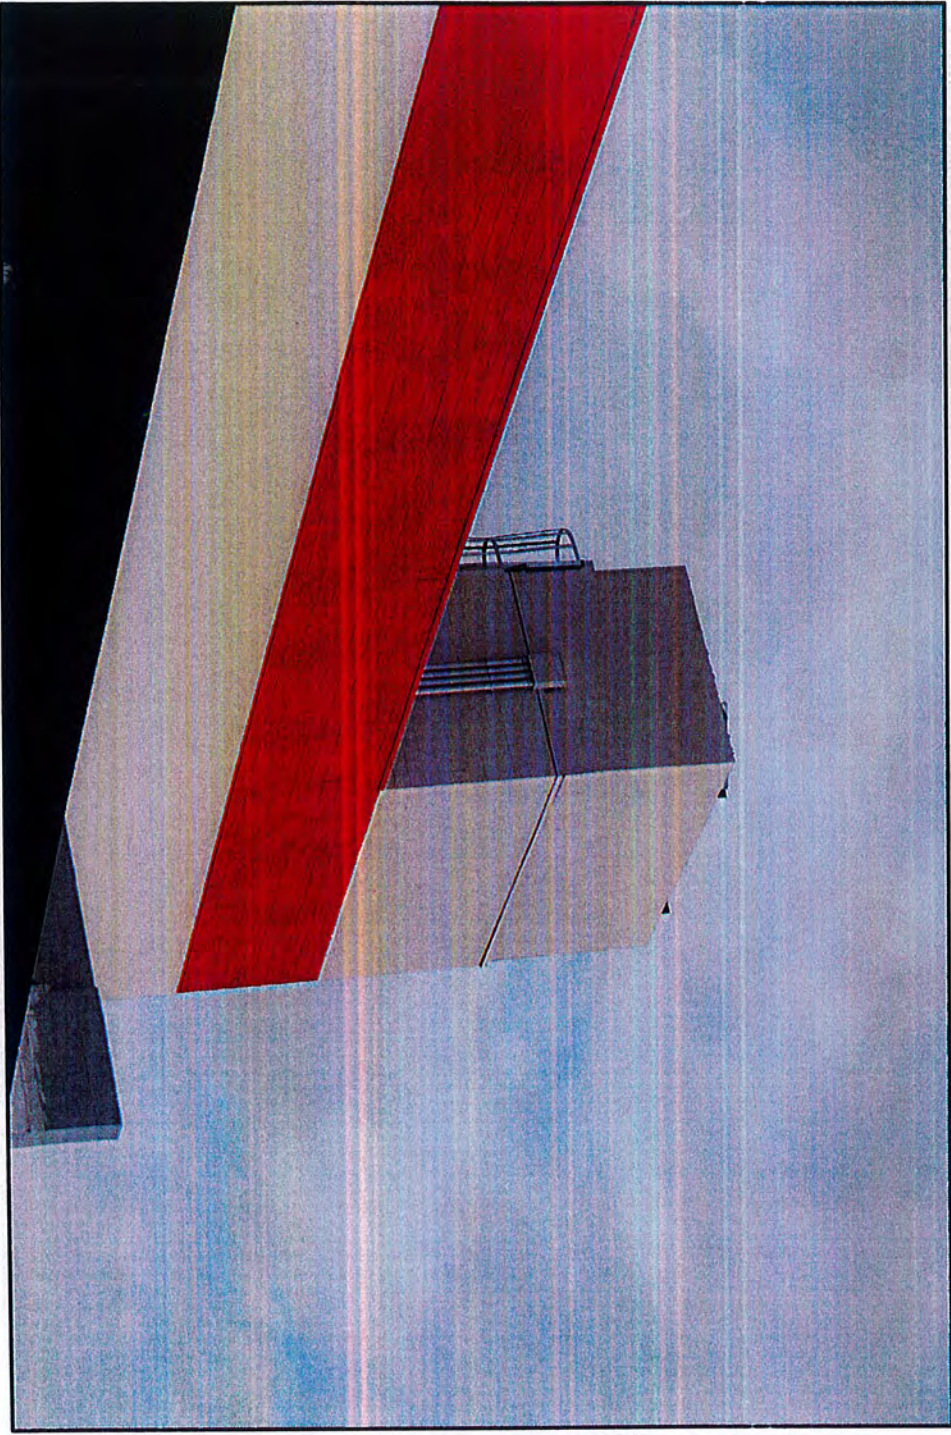





**COUNTY OF SAN MATEO - PLANNING AND BUILDING DEPARTMENT**

**ATTACHMENT D**



---

## Radio Frequency Emissions Compliance Report For AT&T Mobility

Site Name:	Harbor Boulevard and O'Neill Avenue	Site Structure Type:	Rooftop
Address:	333 O'Neill Avenue Belmont, CA 94002	Latitude:	37.522405
Report Date:	October 21, 2021	Longitude:	-122.268358
		Project:	Modification

---


### Compliance Statement

Based on information provided by AT&T Mobility and predictive modeling, the Harbor Boulevard and O'Neill Avenue installation proposed by AT&T Mobility will be compliant with Radiofrequency Radiation Exposure Limits of 47 C.F.R. §§ 1.1307(b)(3) and 1.1310. At the rooftop of 333 O'Neill Avenue, delineating areas that are predicted to exceed the FCC MPE limits with barriers and RF alerting signage and restricting access to these areas to authorized personnel that have completed RF safety training is required for Occupational environment compliance. The proposed operation will not expose members of the General Public to hazardous levels of RF energy at ground level or in adjacent buildings.

### Certification

I, David C. Cotton, Jr., am the reviewer and approver of this report and am fully aware of and familiar with the Rules and Regulations of both the Federal Communications Commissions (FCC) and the Occupational Safety and Health Administration (OSHA) with regard to Human Exposure to Radio Frequency Radiation, specifically in accordance with FCC's OET Bulletin 65. I have reviewed this Radio Frequency Exposure Assessment report and believe it to be both true and accurate to the best of my knowledge.



  
David Charles Cotton, Jr.  
Registered Professional Engineer (Electrical)  
State of California, 18838

### General Summary

The compliance framework is derived from the Federal Communications Commission (FCC) Rules and Regulations for preventing human exposure in excess of the applicable Maximum Permissible Exposure ("MPE") limits. At any location at this site, the power density resulting from each transmitter may be expressed as a percentage of the frequency-specific limits and added to determine if 100% of the exposure limit has been exceeded. The FCC Rules define two tiers of permissible exposure differentiated by the situation in which the exposure takes place and/or the status of the individuals who are subject to exposure. General Population / Uncontrolled exposure limits apply to those situations in which persons may not be aware of the presence of electromagnetic energy, where exposure is not employment-related, or where persons cannot exercise control over their exposure. Occupational / Controlled exposure limits apply to situations in which persons are exposed as a consequence of their employment, have been made fully aware of the potential for exposure, and can exercise control over their exposure. Based on the criteria for these classifications, the FCC General Population limit is considered to be a level that is safe for continuous exposure time. The FCC General Population limit is 5 times more restrictive than the Occupational limits.

In situations where the predicted MPE exceeds the General Population threshold in an accessible area as a result of emissions from multiple transmitters, FCC licensees that contribute greater than 5% of the aggregate MPE share responsibility for mitigation.

Table 1: FCC Limits

Frequency (MHz)	Limits for General Population/ Uncontrolled Exposure		Limits for Occupational/ Controlled Exposure	
	Power Density (mW/cm <sup>2</sup> )	Averaging Time (minutes)	Power Density (mW/cm <sup>2</sup> )	Averaging Time (minutes)
30-300	0.2	30	1	6
300-1500	f/1500	30	f/300	6
1500-100,000	1.0	30	5.0	6

f=Frequency (MHz)

Based on the computational guidelines set forth in FCC OET Bulletin 65, Waterford Consultants, LLC has developed software to predict the overall Maximum Permissible Exposure possible at any location given the spatial orientation and operating parameters of multiple RF sources. The power density in the Far Field of an RF source is specified by OET-65 Equation 5 as follows:


$$S = \frac{EIRP}{4 \cdot \pi \cdot R^2} \text{ (mW/cm}^2\text{)}$$

where EIRP is the Effective Radiated Power relative to an isotropic antenna and R is the distance between the antenna and point of study. Additionally, consideration is given to the manufacturers' horizontal and vertical antenna patterns as well as radiation reflection. At any location, the predicted power density in the Far Field is the spatial average of points within a 0 to 6-foot vertical profile that a person would occupy. Near field power density is based on OET-65 Equation 20 stated as

$$S = \left( \frac{180}{\theta_{BW}} \right) \cdot \frac{100 \cdot P_{in}}{\pi \cdot R \cdot h} \text{ (mW/cm}^2\text{)}$$

where P<sub>in</sub> is the power input to the antenna, θ<sub>BW</sub> is the horizontal pattern beamwidth and h is the aperture length.

Some antennas employ beamforming technology where RF energy allocated to each customer device is dynamically directed toward their location. In the analysis presented herein, predicted exposure levels are based on a statistical distribution of all beams being spread in different directions during the 6-minute averaging time. This statistical approach equates to a "power reduction factor" and conservatively utilizes the lowest 95th percentile value {b-IEC TR 62669}. With a technology duty cycle of 0.75 for Time Division Duplexing associated with downlink transmissions, the actual maximum power (averaged over 6 minutes) is therefore 25% of the maximum power. These results are supported by carriers as well as equipment manufacturer measurement testing.

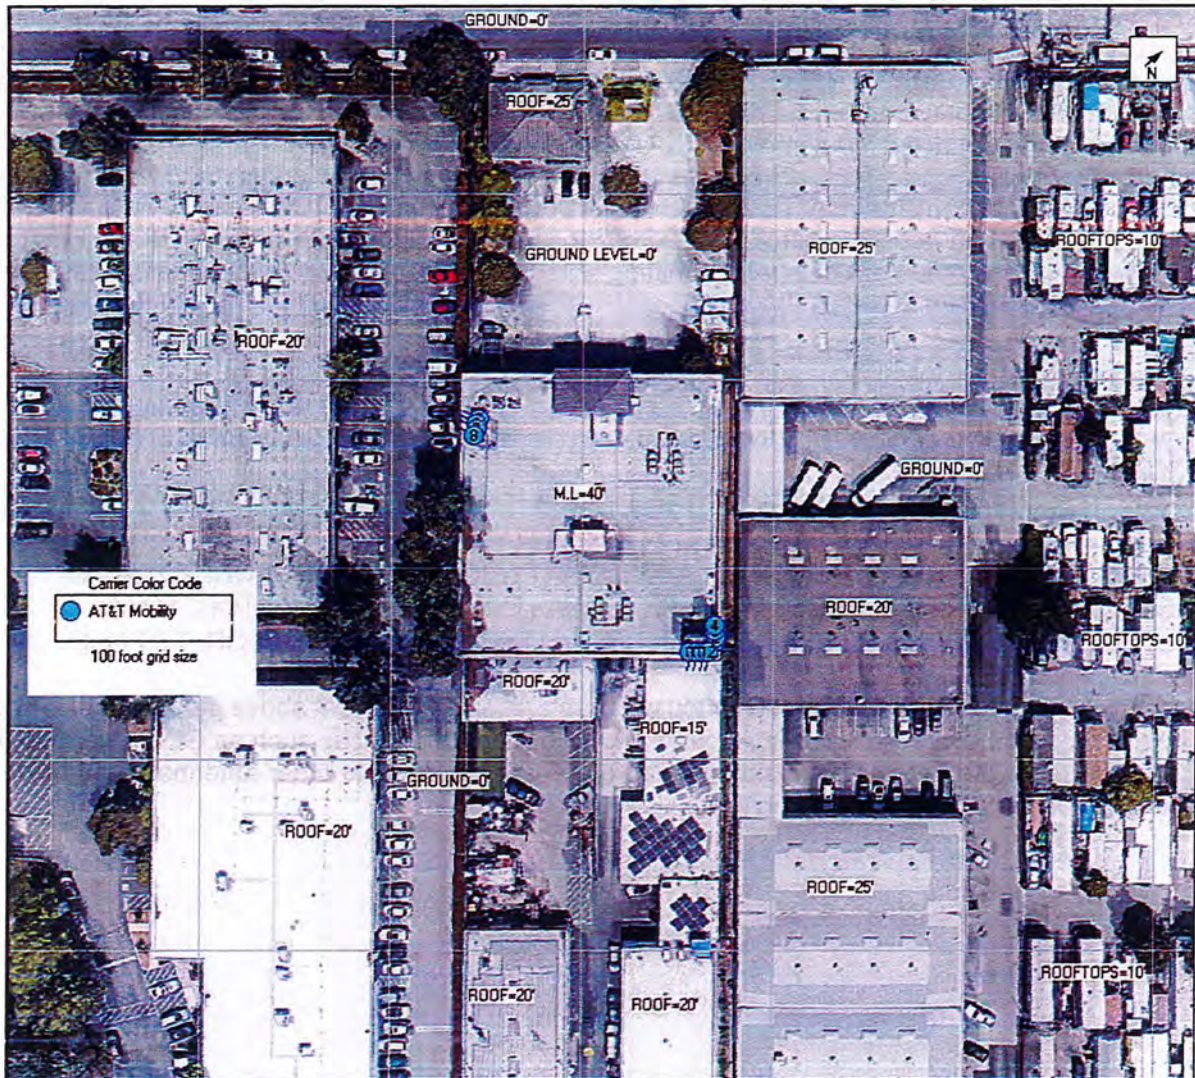

Power density decreases significantly with distance from any antenna. The panel-type antennas to be employed at this site are highly directional by design and the orientation in azimuth and mounting elevation, as documented, serves to reduce the potential to exceed MPE limits at any location other than directly in front of the antennas. For accessible areas at ground level, the maximum predicted power density level resulting from all AT&T Mobility operations is 6.57% of the FCC General Population limits. Incident at adjacent buildings depicted in Figure 1, the maximum predicted power density level resulting from all AT&T Mobility operations is 12.2351% of the FCC General Population limits. The proposed operation will not expose members of the General Public to hazardous levels of RF energy at ground level or in adjacent buildings.

For accessible areas at the roof level of 333 O'Neill Avenue, the maximum predicted power density level resulting from all AT&T Mobility operations is 777.736% of the FCC Occupational limits (3888.68% of the FCC General Population limits). Based on the operating parameters in Appendix A, the maximum cumulative predicted power density level from all antennas on the interior top floor is 19.55% of the FCC General Population limits. For areas on the roof near the antennas that are predicted to exceed the General Population limits, barriers and RF alerting signs (Caution) should be posted to be visible upon approach to provide

For any area in excess of 100% General Population MPE, access controls with appropriate RF alerting signage must be put in place and maintained to restrict access to authorized personnel. Signage must be posted to be visible upon approach from any direction to provide notification of potential conditions within these areas. Subject to other site security requirements, occupational personnel should be trained in RF safety and equipped with personal protective equipment (e.g. RF personal monitor) designed for safe work in the vicinity of RF emitters. Controls such as physical barriers to entry imposed by locked doors, hatches and ladders or other access control mechanisms may be supplemented by alarms that alert the individual and notify site management of a breach in access control. Waterford Consultants, LLC recommends that any work activity in these designated areas or in front of any transmitting antennas be coordinated with all wireless tenants.

### **Analysis**

AT&T Mobility proposes the following installation at this location:

- SWAP (3) EXISTING ANTENNAS IN POS 2,3,4 WITH (3) NEW 8-PORT ANTENNAS (TYPICAL EACH SECTOR, TOTAL OF 9)
- SWAP (1) RRUS-12 WITH (1) NEW RRUS 4415 B25 (TYPICAL EACH SECTOR, TOTAL OF 3)
- INSTALL (1) NEW RRU 4478 B14 NEAR ANTENNA (TYPICAL EACH SECTOR, TOTAL OF 3)
- INSTALL (1) NEW RRU 4478 B5 NEAR ANTENNA (TYPICAL EACH SECTOR, TOTAL OF 3)
- INSTALL (1) NEW RRU 4426 B66 NEAR ANTENNA (TYPICAL EACH SECTOR, TOTAL OF 3)
- INSTALL (1) NEW RRUS-E2 B29 NEAR ANTENNA (TYPICAL EACH SECTOR, TOTAL OF 3)

The antennas will be mounted on a 40-foot Rooftop with centerlines 57 & 45 feet above ground level. Proposed antenna operating parameters are listed in Appendix A. Other appurtenances such as GPS antennas, RRUs and hybrid cable below the antennas are not sources of RF emissions. No other antennas are known to be operating in the vicinity of this site.

notification of potential conditions at these areas. These recommendations are depicted in Figure 2. Any work activity in front of transmitting antennas should be coordinated with AT&T Mobility.

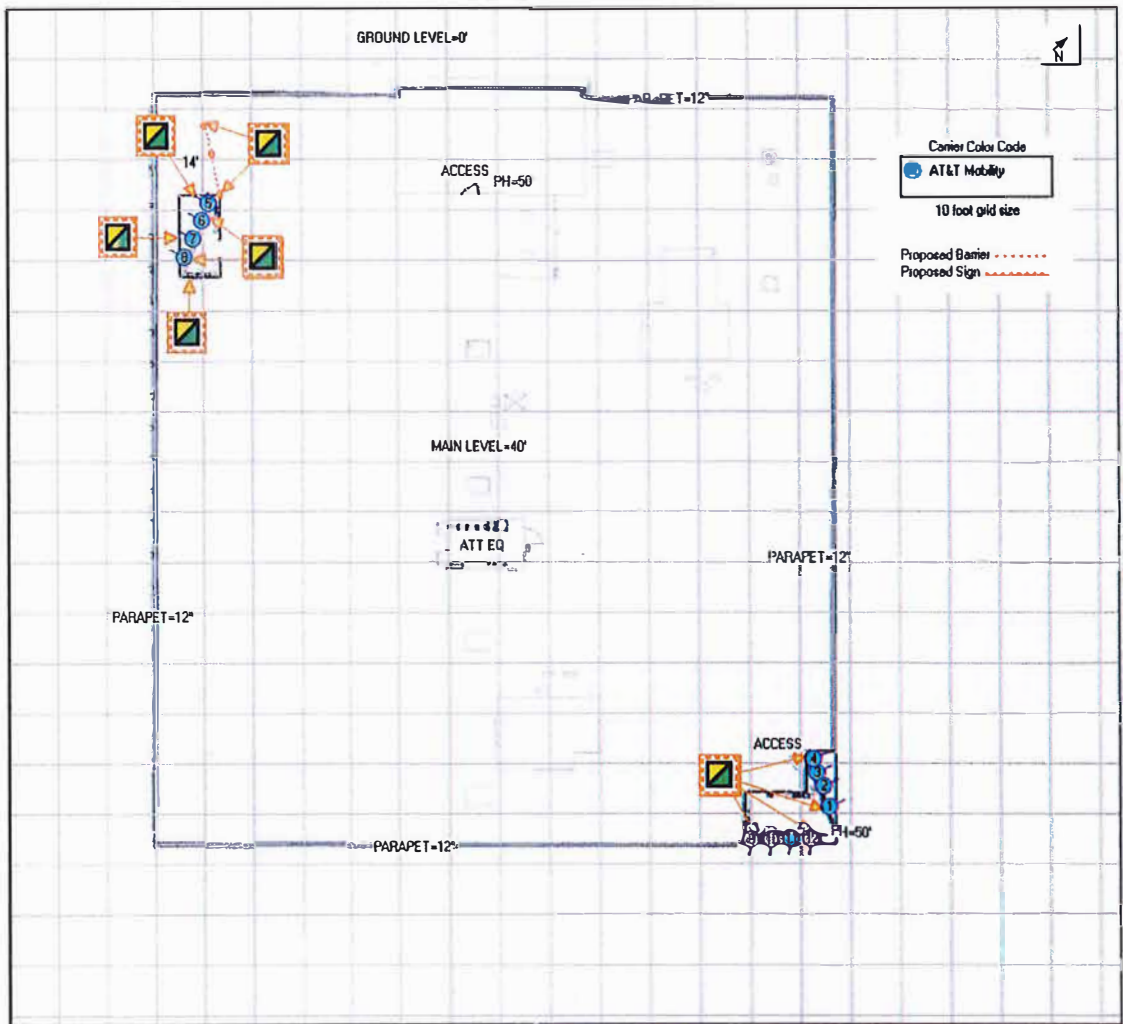


Figure 2: Mitigation Recommendations

**Recommendations**

**AT&T Mobility All Sectors**  
 Caution 2 sign required behind antennas on all sectors.

AND

Caution 2 sign required on the barrier post and on the front of the antenna on the screen wall on beta sector.

**Materials –**

**Alpha**  
 2 Caution 2 Signs

**Beta**  
 3 Post,  
 7 Caution 2 Signs,  
 Roughly 14' Chain.  
 Barriers Space – 14'

**Gamma**  
 2 Caution 2 Signs

**\*\*Barriers must be built a minimum of 6 feet away from unprotected roof edge. Minimum of 36" of parapet wall**

**Appendix A: Operating Parameters Considered in this Analysis**

Antenna #:	Carrier:	Manufacturer	Pattern:	Band (MHz):	Mech Az (deg):	Mech DT (deg):	H BW (deg):	Length (ft):	TPO (W):	Channels:	Loss (dB):	Gain (dBi):	ERP (W):	EIRP (W):	Rad Center (ft):
1	AT&T	COMMSCOPE	SBNHH-1D65B-SR 00DT	700	20	0	68	6.1	30	2	0	12.26	1010	1656	57
1	AT&T	COMMSCOPE	SBNHH-1D65B 00DT	1900	20	0	66	6.1	40	4	0	15.89	6210	10189	57
2	AT&T	COMMSCOPE	JAHH-65B-R3B 02DT	700	20	0	67	6	40	2	0	12.11	1300	2133	57
2	AT&T	COMMSCOPE	JAHH-65B-R3B 02DT	850	20	0	64	6	40	2	0	12.81	1528	2507	57
2	AT&T	COMMSCOPE	JAHH-65B-R3B 00DT	2300	20	0	65	6	25	4	0	16.06	4036	6622	57
3	AT&T	COMMSCOPE	JAHH-65B-R3B 02DT	700	20	0	67	6	40	2	0	12.11	1300	2133	57
3	AT&T	COMMSCOPE	JAHH-65B-R3B 02DT	850	20	0	64	6	60	2	0	12.81	2292	3760	57
3	AT&T	COMMSCOPE	JAHH-65B-R3B 00DT	2100	20	0	65	6	60	4	0	15.71	8937	14663	57
4	AT&T	COMMSCOPE	JAHH-65B-R3B 02DT	700	20	0	67	6	40	2	0	12.11	1300	2133	57
4	AT&T	COMMSCOPE	JAHH-65B-R3B 02DT	850	20	0	64	6	60	2	0	12.81	2292	3760	57
5	AT&T	COMMSCOPE	SBNHH-1D65B-SR 00DT	700	250	0	68	6.1	30	2	0	12.26	1010	1656	45
5	AT&T	COMMSCOPE	SBNHH-1D65B 00DT	1900	250	0	66	6.1	40	4	0	15.89	6210	10189	45
6	AT&T	COMMSCOPE	JAHH-65B-R3B 02DT	700	250	0	67	6	40	2	0	12.11	1300	2133	45
6	AT&T	COMMSCOPE	JAHH-65B-R3B 02DT	850	250	0	64	6	40	2	0	12.81	1528	2507	45
6	AT&T	COMMSCOPE	JAHH-65B-R3B 00DT	2300	250	0	65	6	25	4	0	16.06	4036	6622	45
7	AT&T	COMMSCOPE	JAHH-65B-R3B 02DT	700	250	0	67	6	40	2	0	12.11	1300	2133	45
7	AT&T	COMMSCOPE	JAHH-65B-R3B 02DT	850	250	0	64	6	60	2	0	12.81	2292	3760	45
7	AT&T	COMMSCOPE	JAHH-65B-R3B 00DT	2100	250	0	65	6	60	4	0	15.71	8937	14663	45
8	AT&T	COMMSCOPE	JAHH-65B-R3B 02DT	700	250	0	67	6	40	2	0	12.11	1300	2133	45
8	AT&T	COMMSCOPE	JAHH-65B-R3B 02DT	850	250	0	64	6	60	2	0	12.81	2292	3760	45
9	AT&T	COMMSCOPE	SBNHH-1D65B-SR 00DT	700	140	0	68	6.1	30	2	0	12.26	1010	1656	57
9	AT&T	COMMSCOPE	SBNHH-1D65B 00DT	1900	140	0	66	6.1	40	4	0	15.89	6210	10189	57
10	AT&T	COMMSCOPE	JAHH-65B-R3B 02DT	700	140	0	67	6	40	2	0	12.11	1300	2133	57
10	AT&T	COMMSCOPE	JAHH-65B-R3B 02DT	850	140	0	64	6	40	2	0	12.81	1528	2507	57
10	AT&T	COMMSCOPE	JAHH-65B-R3B 00DT	2300	140	0	65	6	25	4	0	16.06	4036	6622	57
11	AT&T	COMMSCOPE	JAHH-65B-R3B 02DT	700	140	0	67	6	40	2	0	12.11	1300	2133	57



Harbor Boulevard and O'neill Avenue - Modification 10.21.2021

Antenna #:	Carrier:	Manufacturer	Pattern:	Band (MHz):	Mech Az (deg):	Mech DT (deg):	H BW (deg):	Length (ft):	TPO (W):	Channels:	Loss (dB):	Gain (dBd):	ERP (W):	EIRP (W):	Rad Center (ft):
11	AT&T	COMMSCOPE	JAHH-65B-R3B 02DT	850	140	0	64	6	60	2	0	12.81	2292	3760	57
11	AT&T	COMMSCOPE	JAHH-65B-R3B 00DT	2100	140	0	65	6	60	4	0	15.71	8937	14663	57
12	AT&T	COMMSCOPE	JAHH-65B-R3B 02DT	700	140	0	67	6	40	2	0	12.11	1300	2133	57
12	AT&T	COMMSCOPE	JAHH-65B-R3B 02DT	850	140	0	64	6	60	2	0	12.81	2292	3760	57

Notes: Table depicts recommended operating parameters for AT&T Mobility proposed operations.



COUNTY OF SAN MATEO - PLANNING AND BUILDING DEPARTMENT

# ATTACHMENT E

County of San Mateo  
Planning and Building Department

**RECOMMENDED FINDINGS AND CONDITIONS OF APPROVAL**

Permit or Project File Number: PLN 2011-00077

Hearing Date: September 1, 2011

Prepared By: Joseph Camicia, Project Planner

For Adoption By: Zoning Hearing Officer

**RECOMMENDED FINDINGS**

For the Environmental Review, Find:

1. That the project is categorically exempt from the California Environmental Quality Act (CEQA) under provisions of Class 3, Section 15303 (construction of small facilities) of the CEQA Guidelines.

For the Use Permit, Find:

2. That the establishment, maintenance and/or conducting of the proposed use will not, under the circumstances of this particular case, be detrimental to the public welfare or injurious to property or improvements in said neighborhood because the facility will not introduce any significant visual, noise, odor, or light impacts to the surrounding neighborhood.
3. That the approval of this use permit renewal for an existing cellular telecommunication facility is necessary for the public health, safety, convenience or welfare of the community as the site provides telecommunications coverage to the surrounding community, which serves as a benefit to both private and public users.

**CONDITIONS OF APPROVAL**

1. This approval applies only to the proposal, documents, and plans described in this report and submitted to and approved by the Zoning Hearing Officer on September 1, 2011. Modifications beyond that which was approved by the Zoning Hearing Officer will be subject to review and approval by the Community Development Director and may require review at a public hearing. Minor modifications that are largely consistent with this approval may be approved at the discretion of the Community Development Director.
2. This permit shall be valid for ten (10) years from the date of this approval and shall expire on September 1, 2011. If continuation of this use is desired, the applicant shall file a use permit renewal application with the Planning and Building Department six months prior to its expiration and pay the fees applicable at that time.

3. The applicant shall paint all new rooftop facilities a light brown/beige color to match that of the existing building and be consistent with the photosimulations on file. The applicant shall arrange for color verification prior to calling for a final inspection.
4. The applicant shall continue to maintain the color of all existing facilities in a manner that is consistent with the color samples on file. Over time paint colors fade and, as result, facilities may become more visually prominent than initially proposed. The applicant shall continue to take all necessary measures to ensure that the site remains consistent with all approved colors. This includes all screen walls and rooftop facilities approved by this permit.
5. This installation shall be removed in its entirety at that time when this technology becomes obsolete, when the facility is no longer needed to achieve coverage objectives, or if the facility remains inactive for six consecutive months. If any of these circumstances occur, the entire facility, including all antennas and associated equipment, cables, power supplies, etc., shall be removed and the site shall be returned to its pre-construction state to the extent practicable.
6. The applicant shall submit proof of its FCC and CPUC licenses/registrations prior to receiving final approval on the building permit. The applicant shall keep their FCC license active and in good standing throughout this permit's 10-year term. The applicant shall immediately notify the Planning and Building Department if any changes to their license occur.

#### Building Inspection Section

7. The applicant shall apply for and obtain a building permit prior to beginning construction of the facilities approved by the Zoning Hearing Officer on September 1, 2011.

JC:cdn - JXCV0572\_WCU.DOC